

NATURE RESERVE

RESERVE NO: 8 33831

GOVERNMENT GAZETTE  
Date Page No.

FILE NUMBER: 147/61

PURPOSE: Conservation of  
Flora and Fauna 23.1.76 133

NAME: Great Sandy Island  
Nature Reserve 4. 6,82 1794

CLASS (Land Act): "B" 13.2.81 617

AREA: 25.8064 ha 23.1.76 133

VESTING: W.A.W.A. 23.1.76 113

LOCATION NO(S):

CLASSIFICATION:  
(Wildlife Act  
Section 12A)

LITHO: 111/300

LOCAL AUTHORITY: ROEBOURNE SHIRE

Notes:



DEPARTMENT OF LANDS AND SURVEYS

Cathedral Avenue,  
Perth,  
Western Australia 6000

Department of Conservation  
and Land Management  
27 JUN 1986  
COMO, W.A.

Your Ref.

Our Ref. 550/73 CN:KMH.

Telephone Enquiries 323 1278.

Executive Director,  
DEPARTMENT OF CONSERVATION AND  
LAND MANAGEMENT.

? Not in Records

"CONSERVATION OF FLORA AND FAUNA" RESERVE 33831

Further to my memo of May 8, 1986 I advise for your information that Executive Council has issued a proclamation cancelling the reservation of that portion of Class "B" Reserve No. 33831 comprised in Ashburton Location 48 and of its area being reduced by 24.2811 hectares.

Notice to this effect was published in the Government Gazette of May 30, 1986 and I enclose a print showing the above.


B. L. O'Nauoran  
UNDER SECRETARY FOR LANDS.

June 25, 1986.

Encl:

~~@ Wildlife~~ First seen 7/4/87  
~~Manager LWA~~

see p. 132

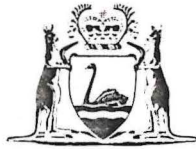

DEPARTMENT OF LAND ADMINISTRATION

Cathedral Avenue,  
Perth,  
Western Australia 6000

187  
126

Your Ref. 015383F3102, F&W 147/61

Our Ref. 550/73 KBE:LG

Telephone  
Enquiries

Department of Conservation  
and Land Management  
12 MAY 1987  
COMO, W.A.

EXECUTIVE DIRECTOR  
DEPARTMENT OF CONSERVATION AND  
LAND MANAGEMENT.

"CONSERVATION OF FLORA AND FAUNA" RESERVE 33831

183

I refer to your memorandum of April 14, 1987 concerning the abovementioned reserve and advise that in line with E.P.A. Recommendation 8.4 - Mary Anne to Regnard Islands, Reserve 33831 was expanded in February, 1981 to include all the portions of land above the low water mark shown within the blue boundary of Reserve Plan 185. Excluded from this area were Ashburton Locations 9 (North Sandy Island) and 35 (Part of Great Sandy Island).

Subsequent investigations revealed that Ashburton Location 48 was inadvertently included into the Reserve. This Location, which covers the whole of Mary Anne Reef, is the subject of Special Lease 3116/4411 to the Commonwealth of Australia for the purpose of "Lighthouse Site". To correct this anomaly the action referred to in my memorandum of June 25, 1986 was carried out. Enclosed is a copy of Reserve Plan 185 for your information.

*A W Muth*  
DIRECTOR,  
LAND OPERATIONS DIVISION

May 11, 1987

Enc.


15.5.87  
~~O. J. L. Reserve~~  
Land Clerk  
15

DOVE AMB.  
2-8-88

2) S.C. Boers a per your request at file 182

Compiled from 1:250 000 MAP SERIES R 502 SHEETS SF 50-2 DAMPIER  
SF 50-5 ONSLOW  
SF 50-6 YARRALOOA

SUPERSEDES RESERVE PLANS 29, 30, 37 & 56

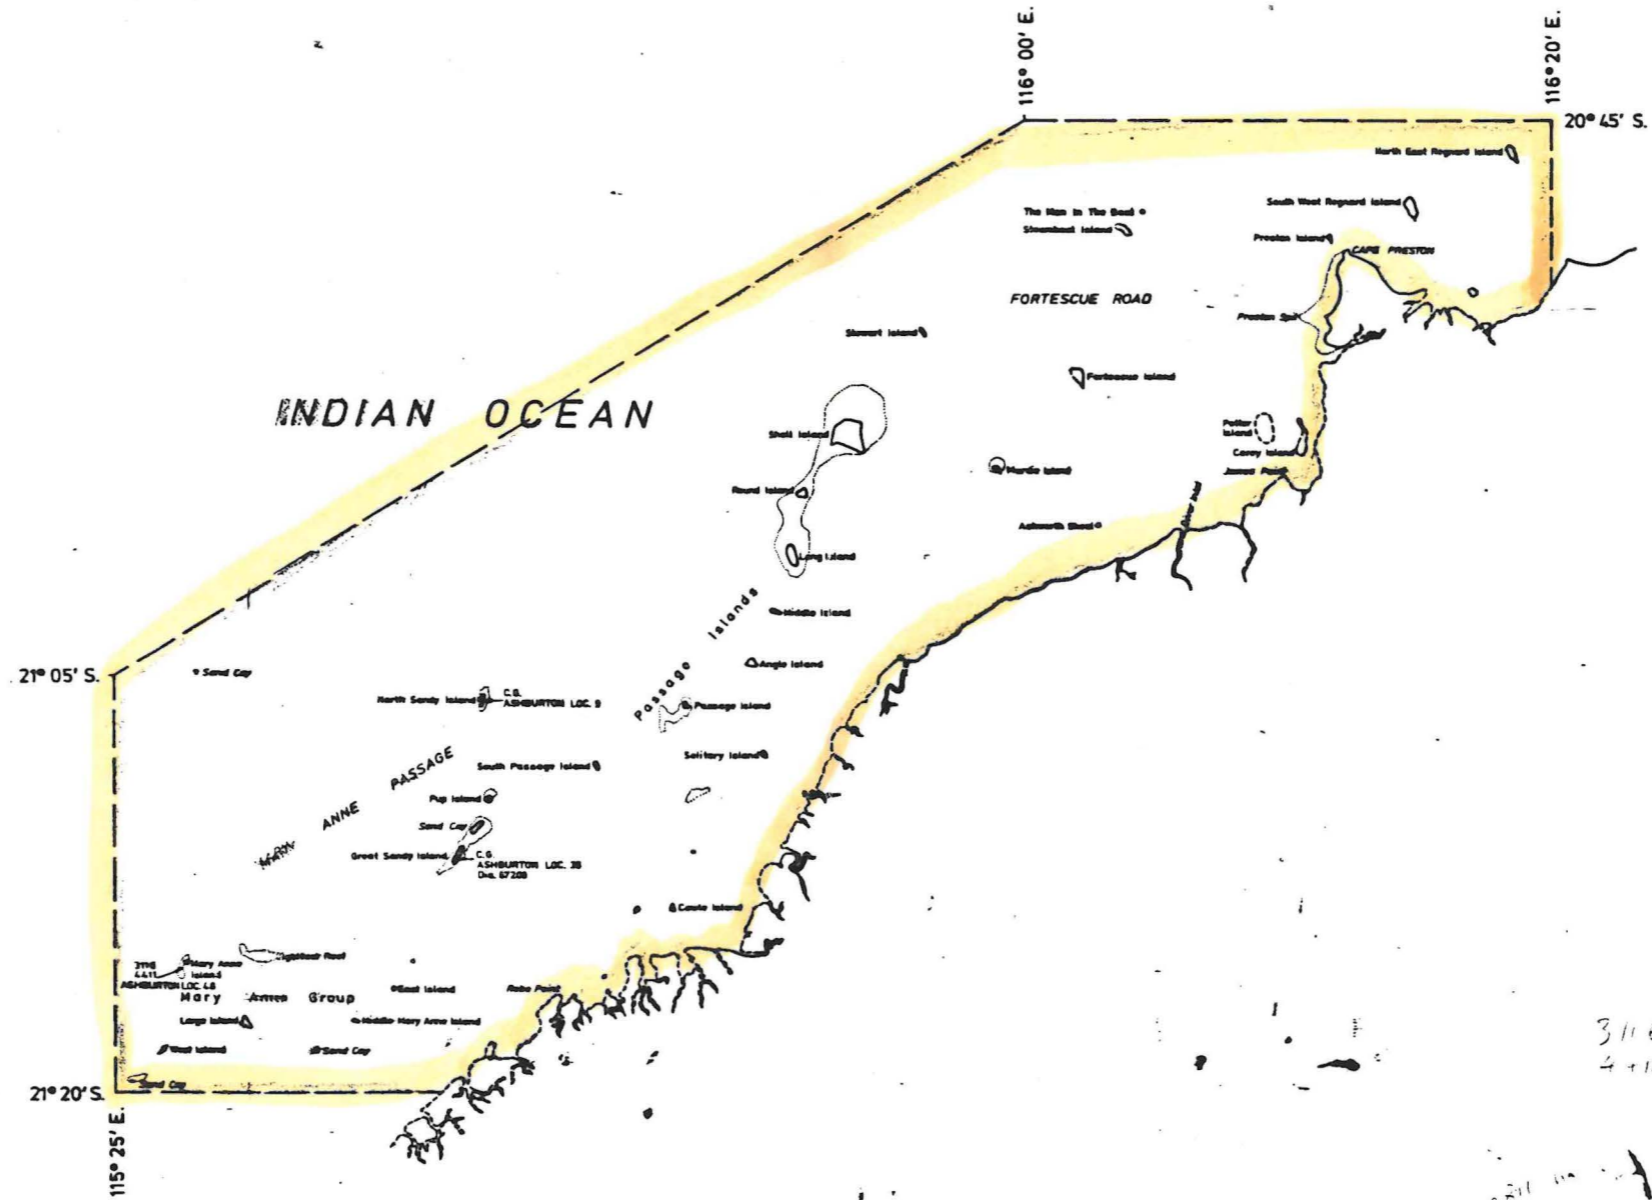

3116  
411

YARRALOOA 1:250000

1763

BOUNDARIES OF RESERVE EXTEND TO LOW WATER MARK.  
EXCLUDES ASHBURTON LOC. 9 (NORTH SANDY ISLAND) & ASHBURTON LOC. 25 (PI GREAT SANDY ISLAND) & ASHBURTON LOC. 48 (MARY ANNE REEF)

CHARTING :- TO SUITABLY ENDORSE RESERVE PLANS 29, 37 & 56 UNW/ RESERVE PLAN

RESERVE No. B 33831		Purpose Conservation of Flora and Fauna		Area Indeterminable.	
CORR. No. 1940/76		AMENDMENTS		SCALE 1:250 000	
DISTRICT DE WITT		Gaz	Page	Intls	SCALE 1:250 000
PUBLIC PLAN Yarralooa, Onslow		30 5 86	1763	C.L.	GAZETTED 13th Feb. 81 PAGE 517
and Dampier & Barrow Island 1:250 000					Recorded on Public Plan JMT 73.81
					Registered