

## RESERVE ACTION SHEET - CONSERVATION RESERVES

**RESERVE No. 46234 (Camp Creek Conservation Park)**

### REASON FOR ACTION

- Creation of a new class A reserve with a Management Order issued to the Conservation Commission for the purpose 'Conservation Park'. Area: 1267 hectares.
- This land was recommended to become a conservation reserve in the early 1990's because the existing reserve proposals for the Mitchell Plateau did not contain examples of the diverse palm and eucalypt communities present there. Camp Creek Conservation Park will protect several monitoring sites within rainforest and includes important riverine vegetation associations and eucalyptus woodlands.
- Date of DOLA's advice: 10 July 2000 See folios: 3 & 7
- Plans at folios: 6, 9 & 10

OFFICER	ACTION		
1	<b>CONSERVATION ESTATE OFFICER</b>	<ul style="list-style-type: none"> <li>- Fill in above details</li> <li>- Attach copies of DOLA's advice to file</li> </ul> <p>Send copies of advice &amp; maps to:</p> <ul style="list-style-type: none"> <li>- Lisa Wright, Woodvale</li> <li>- District Manager, East Kimberly</li> <li>- Regional Manager, Kununurra</li> </ul> <p>Recommended IUCN classification: <u>  I  </u></p> <p>To note: <i>[Signature]</i> <span style="float: right;">19/12/00</span></p>	<p>_____</p> <p>_____</p> <p>_____</p> <p>_____</p> <p>_____</p>
2	<b>INDEX CLERK, RECORDS</b>	<p>To note: _____</p>	
3	<b>LAND ACQUISITIONS OFFICER</b>	<p>To note: _____</p>	
4	<b>MANAGER, PLANNING &amp; VISITOR SERVICES</b>	<p>To note &amp; approve IUCN classification: _____</p>	
5	<b>DIRECTOR, NATURE CONSERVATION/ NATIONAL PARKS</b>	<p>To note: _____</p>	
6	<b>PROGRAM LEADER (TENURE)</b>	<p>To note &amp; update IUCN records: _____</p>	

**Customer Advices for Reserve Actions  
1/07/2000 - 31/07/2000**

**Shire of Wyndham-East Kimberley 1/07/2000 - 31/07/2000**

Reserve No.	Land Description	DOLA File No.	Volume/Folio	Action	Document No.	Registered	Street Name	Area	Public Plans
46231	Doongan Location 30	02160-1993-01RO	3040-984	Reserve Creation for the designated purpose of "Conservation Park".	H500464			12191 Ha	Montague Sound (250) & Camden Sound and Prince Regent (250)
46232	Doongan Location 33	00543-1994-01RO	3103-225	Reserve Creation for the designated purpose of "National Park".	H500457			115325 Ha	Montague Sound (250) & Camden and Prince Regent (250)
46233	Doongan Location 32	00542-1994-01RO	3103-224	Reserve Creation for the designated purpose of "National Park".	H500459			17572 Ha	Montague Sound (250)
46234	Doongan Location 29	02161-1993-01RO	3120-831	Reserve Creation for the designated purpose of "Conservation Park".	H500462			1267 Ha	Montague Sound (250)

Reserves 46231 - 46234 :

lodgement/Registration date for vesting of all these reserves in NPNCA is 11.7.00

lodgement/Registration for all other actions is 10.7.00

CESAR MURPHY  
16/9/00


THANK YOU,

PLEASE.


FOLD PLANS,

~~CREATING~~  
~~HOME~~

GM 2/8

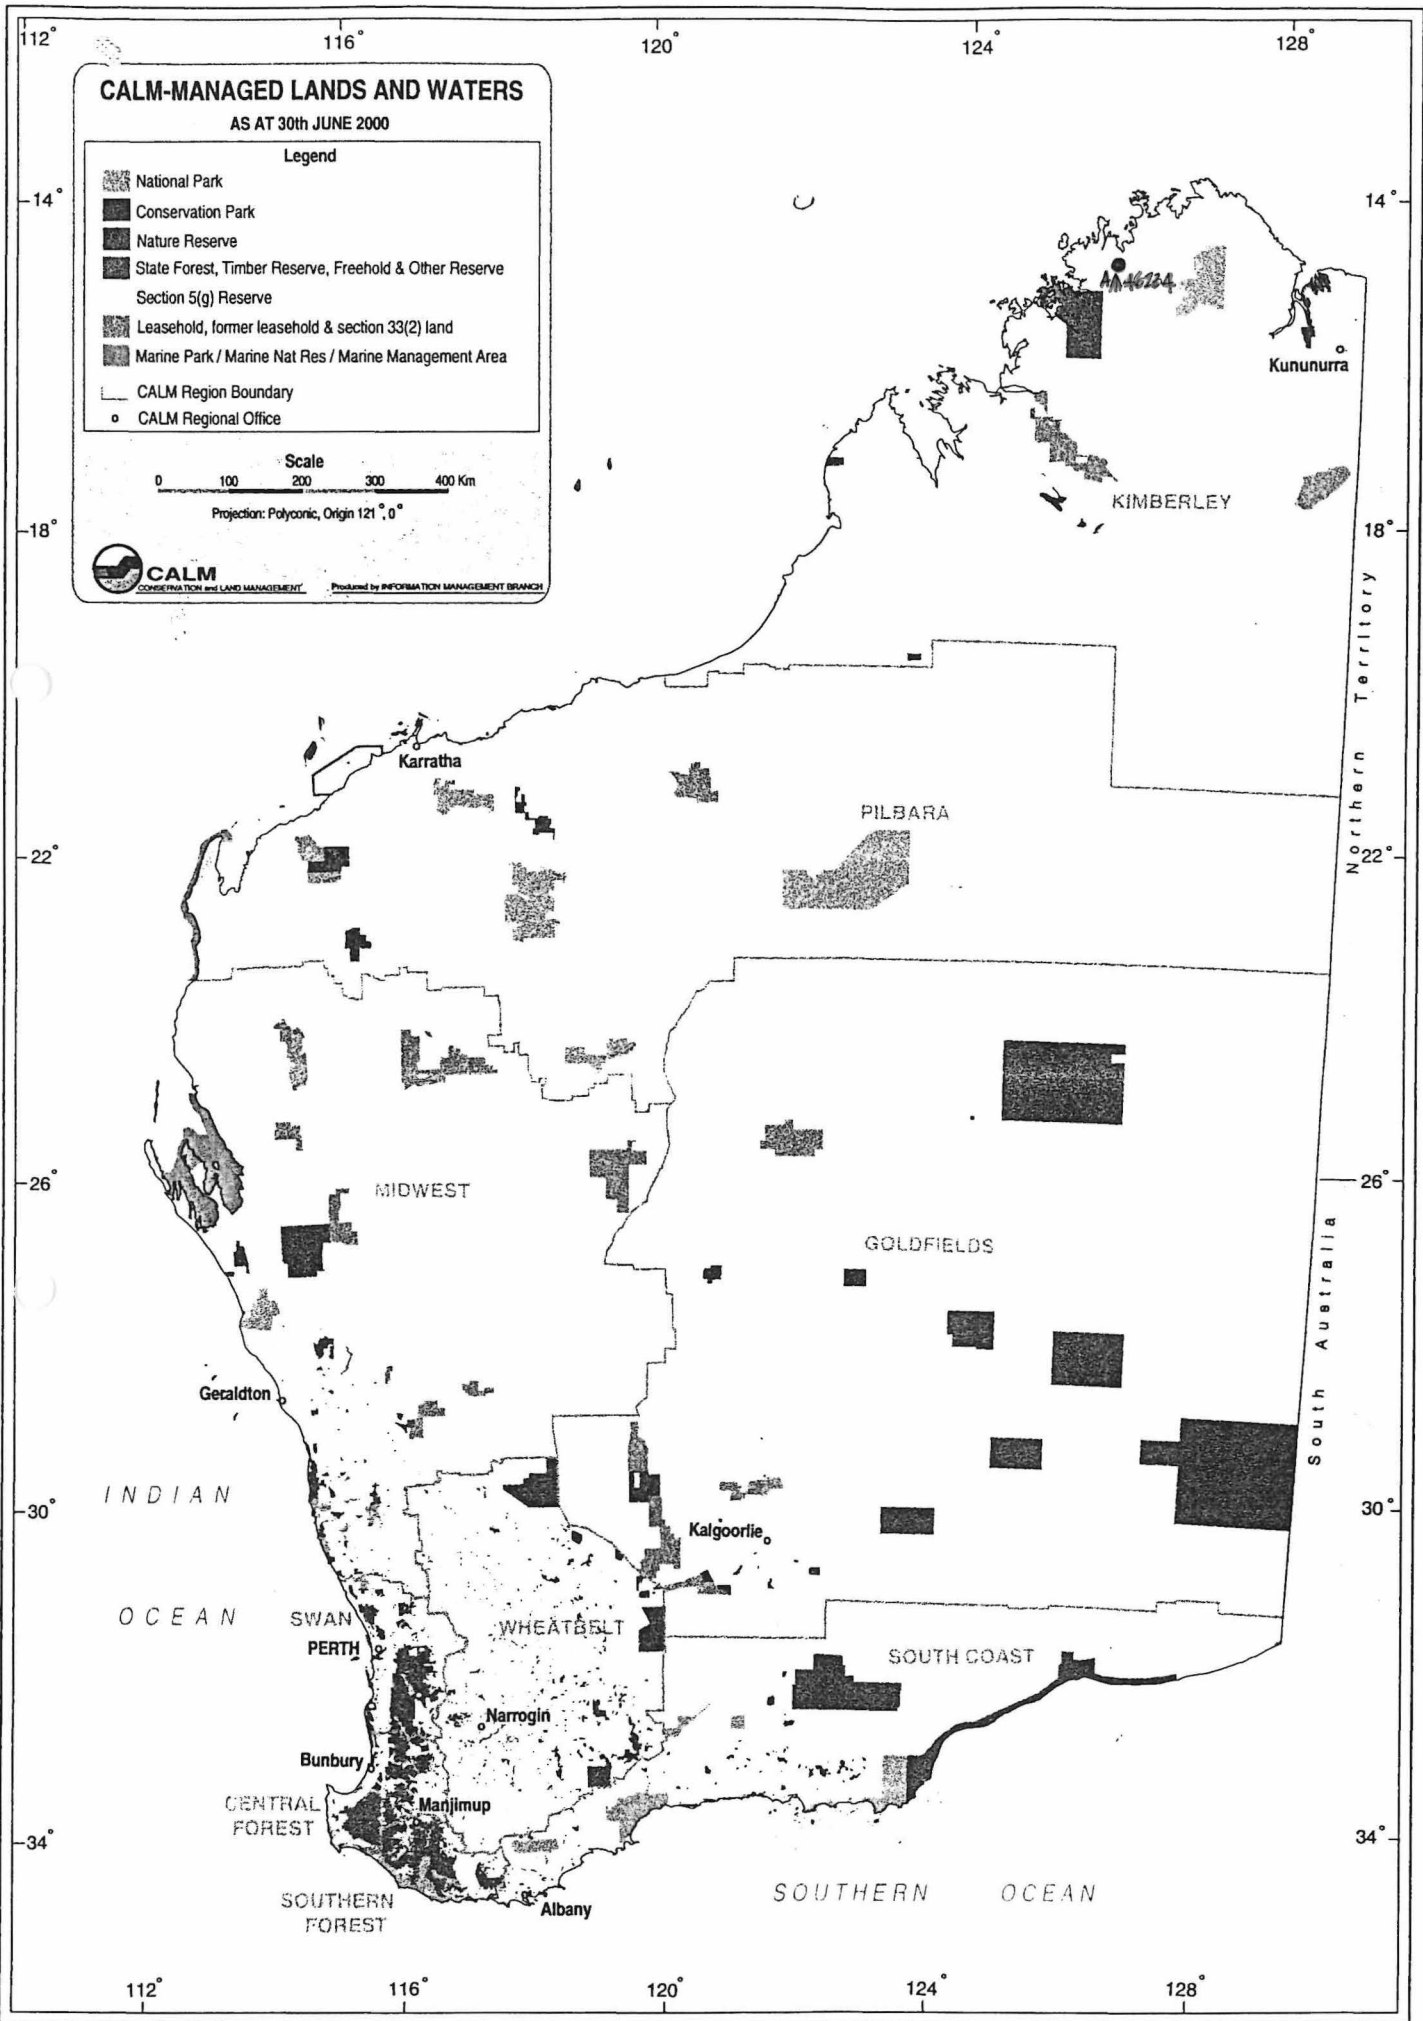

FAC DOA PLAN  
MONTAGUE SOUND (5051-12)  
SCALE 1:250000

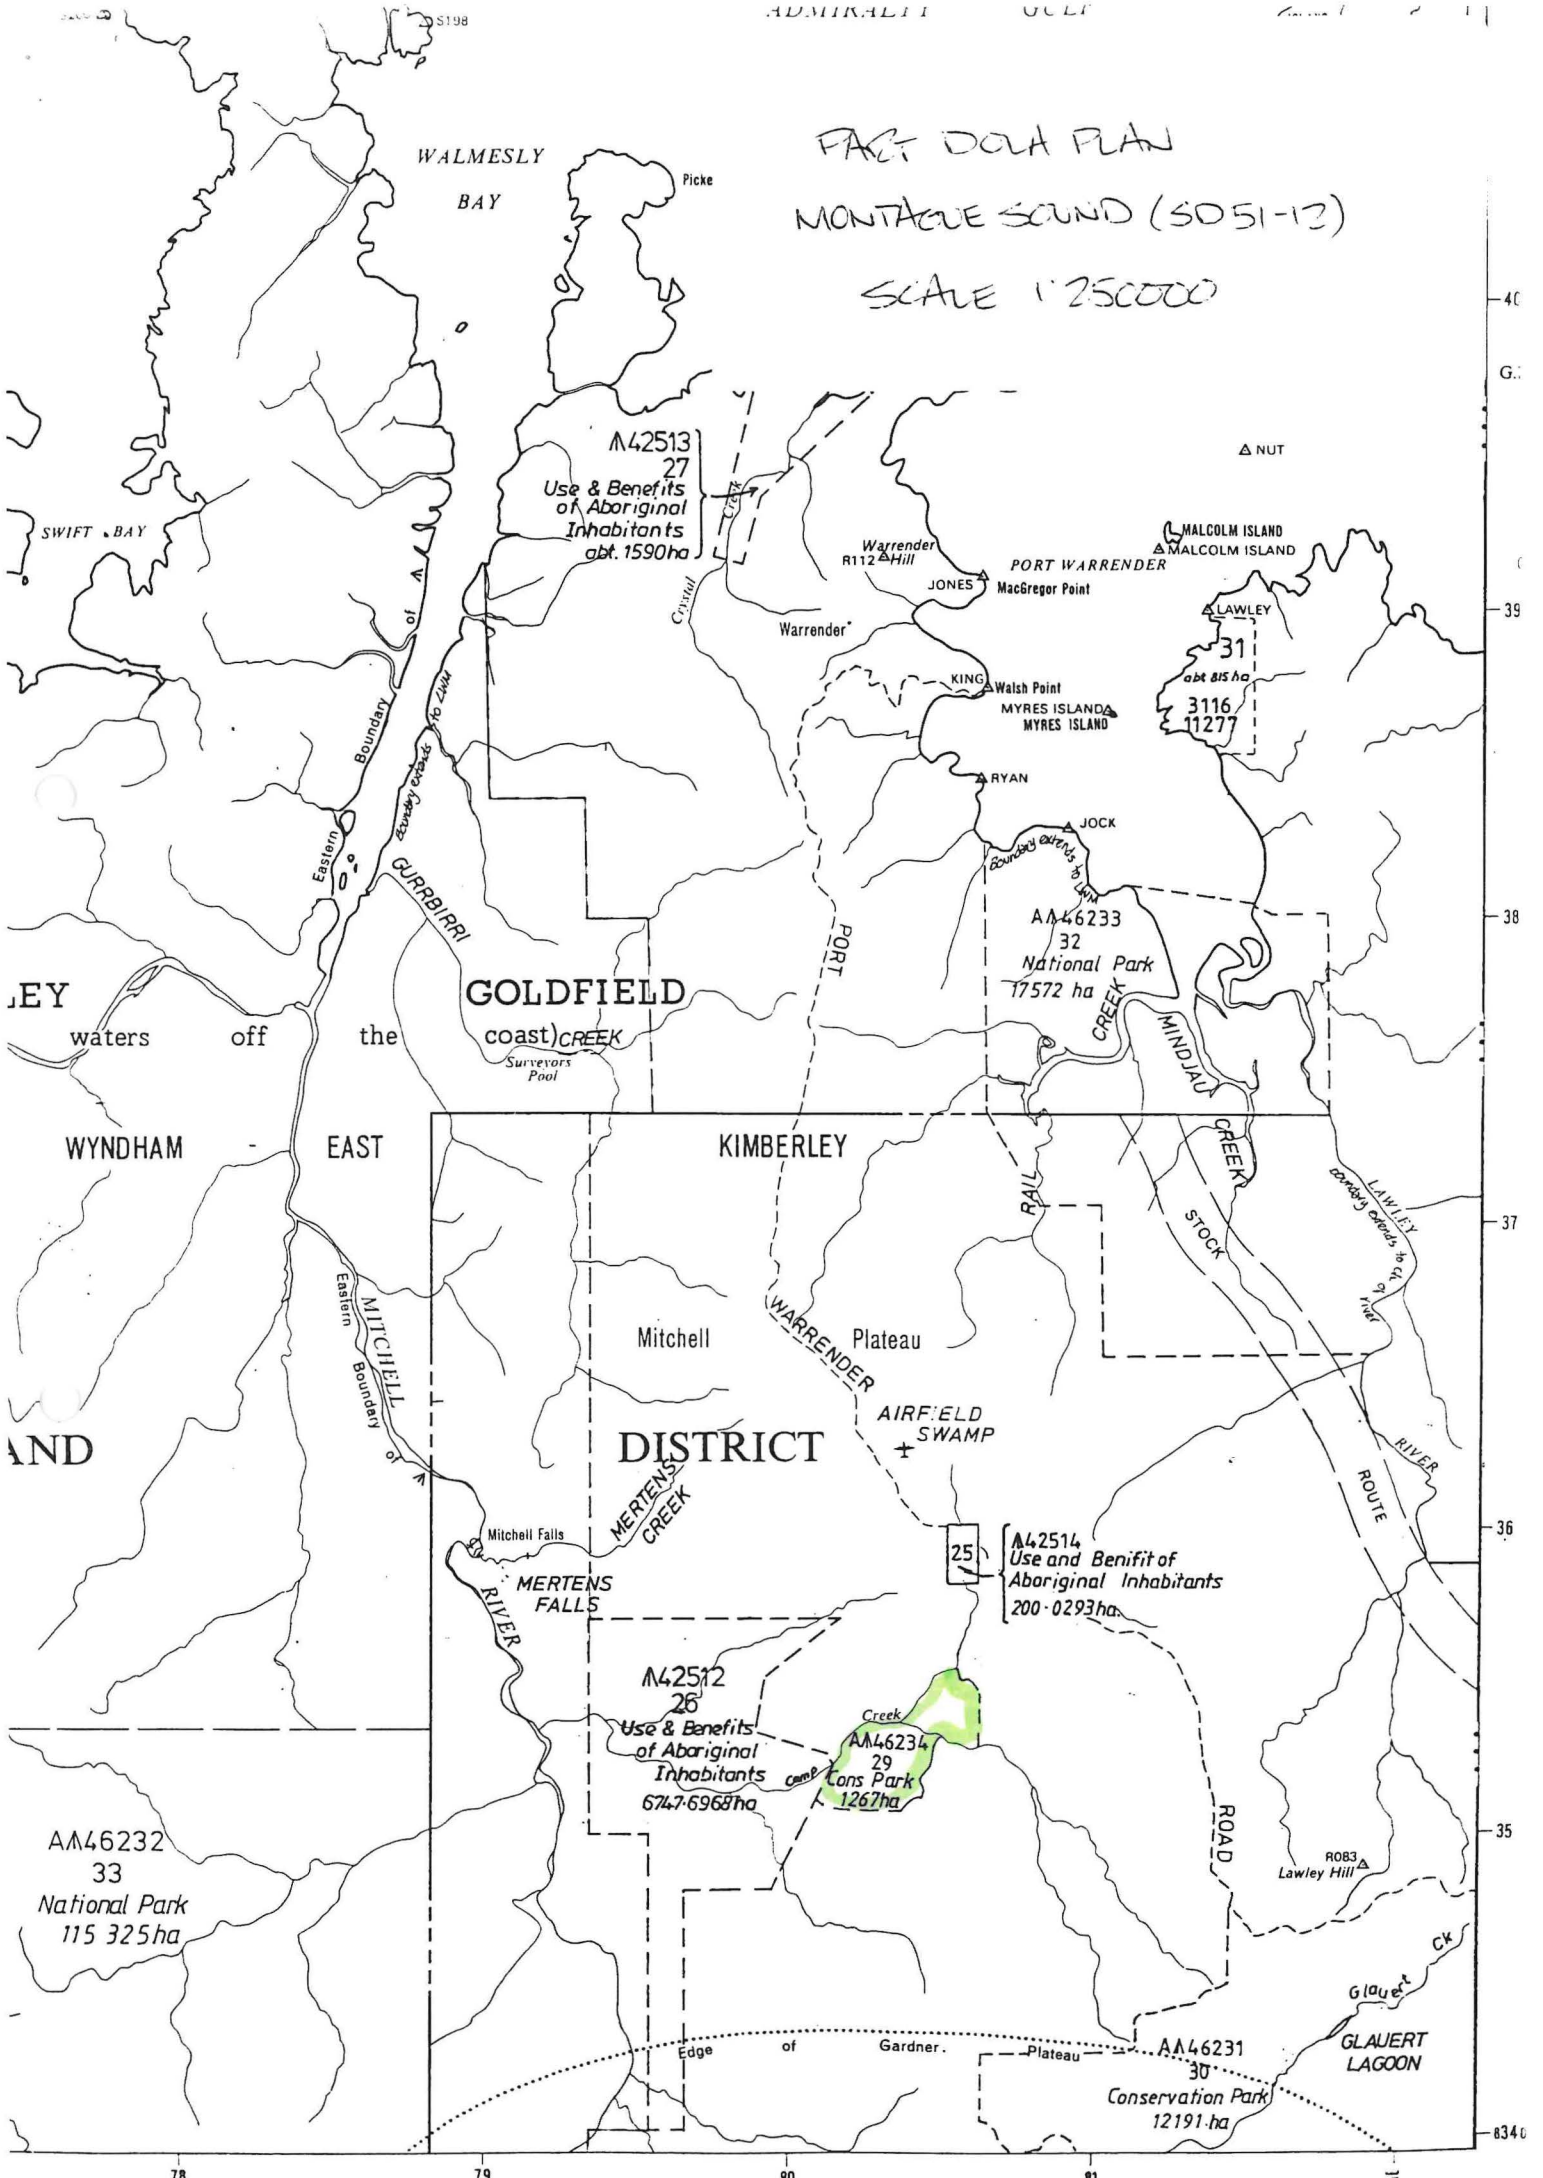

M42513  
27  
Use & Benefits  
of Aboriginal  
Inhabitants  
abt. 1590ha

MALCOLM ISLAND  
MALCOLM ISLAND  
LAWLEY  
31  
abt 815 ha  
3116  
11277

AA46233  
32  
National Park  
17572 ha

25  
M42514  
Use and Benefit of  
Aboriginal Inhabitants  
200-0293ha

M42512  
26  
Use & Benefits  
of Aboriginal  
Inhabitants  
6747-6968ha

AA46234  
29  
Cons Park  
1267ha

AA46232  
33  
National Park  
115 325ha

AA46231  
30  
Conservation Park  
12191 ha