

M29

M21

~~Monitoring~~

John Forest NP.


+ Greenmount Hill

4N



RON

|                                       | B | H | J | A | M | U | K | S | O | G |
|---------------------------------------|---|---|---|---|---|---|---|---|---|---|
| <b>SANTALACEAE</b>                    |   |   |   |   |   |   |   |   |   |   |
| Exocarpus odoratus                    |   |   |   |   |   |   |   |   |   | x |
| E. sparteus                           | x |   |   |   |   |   | x | x |   |   |
| Leptomeria scrobiculata               |   |   | x |   |   |   |   |   |   |   |
| <b>OLEACEAE</b>                       |   |   |   |   |   |   |   |   |   |   |
| Olax phyllanthii                      |   |   |   |   |   | x | x |   |   |   |
| <b>LORANTHACEAE</b>                   |   |   |   |   |   |   |   |   |   |   |
| Ameyema miquellii                     |   |   | x |   |   |   |   |   |   |   |
| Nuytsia floribunda                    |   | x | x | x |   |   |   |   |   |   |
| <b>POLYGONACEAE</b>                   |   |   |   |   |   |   |   |   |   |   |
| Muehlenbeckia appressa                |   |   |   |   |   | x |   |   |   | x |
| <b>CHENOPODIACEAE</b>                 |   |   |   |   |   |   |   |   |   |   |
| Atriplex hypoleuca                    | x |   |   |   |   |   |   |   |   |   |
| Maireana <del>sp.</del> oppositifolia |   |   |   |   |   |   |   |   |   | x |
| Rhagodia baccata                      |   |   |   |   |   |   |   |   |   | x |
| Sarcocornia quinqueflora              |   |   |   |   |   |   |   |   |   |   |
| Threkeldia diffusa                    |   |   |   |   |   |   |   |   |   | x |
| <b>AMARANTACEAE</b>                   |   |   |   |   |   |   |   |   |   |   |
| Hemichroa diandra                     |   |   |   |   |   |   |   |   |   | x |
| <b>PHYTOLACCACEAE</b>                 |   |   |   |   |   |   |   |   |   |   |
| Phytolacca octandra                   | D |   |   |   |   |   |   |   |   |   |
| <b>GYROSTEMONACEAE</b>                |   |   |   |   |   |   |   |   |   |   |
| Gyrostemon sheathii                   |   |   |   |   | x |   |   |   |   | x |
| G. thesioides                         |   |   |   |   | x | x |   |   |   |   |
| <b>IZOACEAE</b>                       |   |   |   |   |   |   |   |   |   |   |
| Carpobrotus edulis                    | D |   |   |   |   |   |   |   |   | x |
| C. modestus                           | x |   |   |   |   |   |   |   |   |   |
| Disphyma clavellatum                  |   |   |   |   |   |   |   |   |   | x |
| Ruschia tumida                        |   |   |   |   |   |   |   |   |   | D |
| Lampranthus galucus-glaucus           | D |   |   |   | D |   |   |   |   |   |

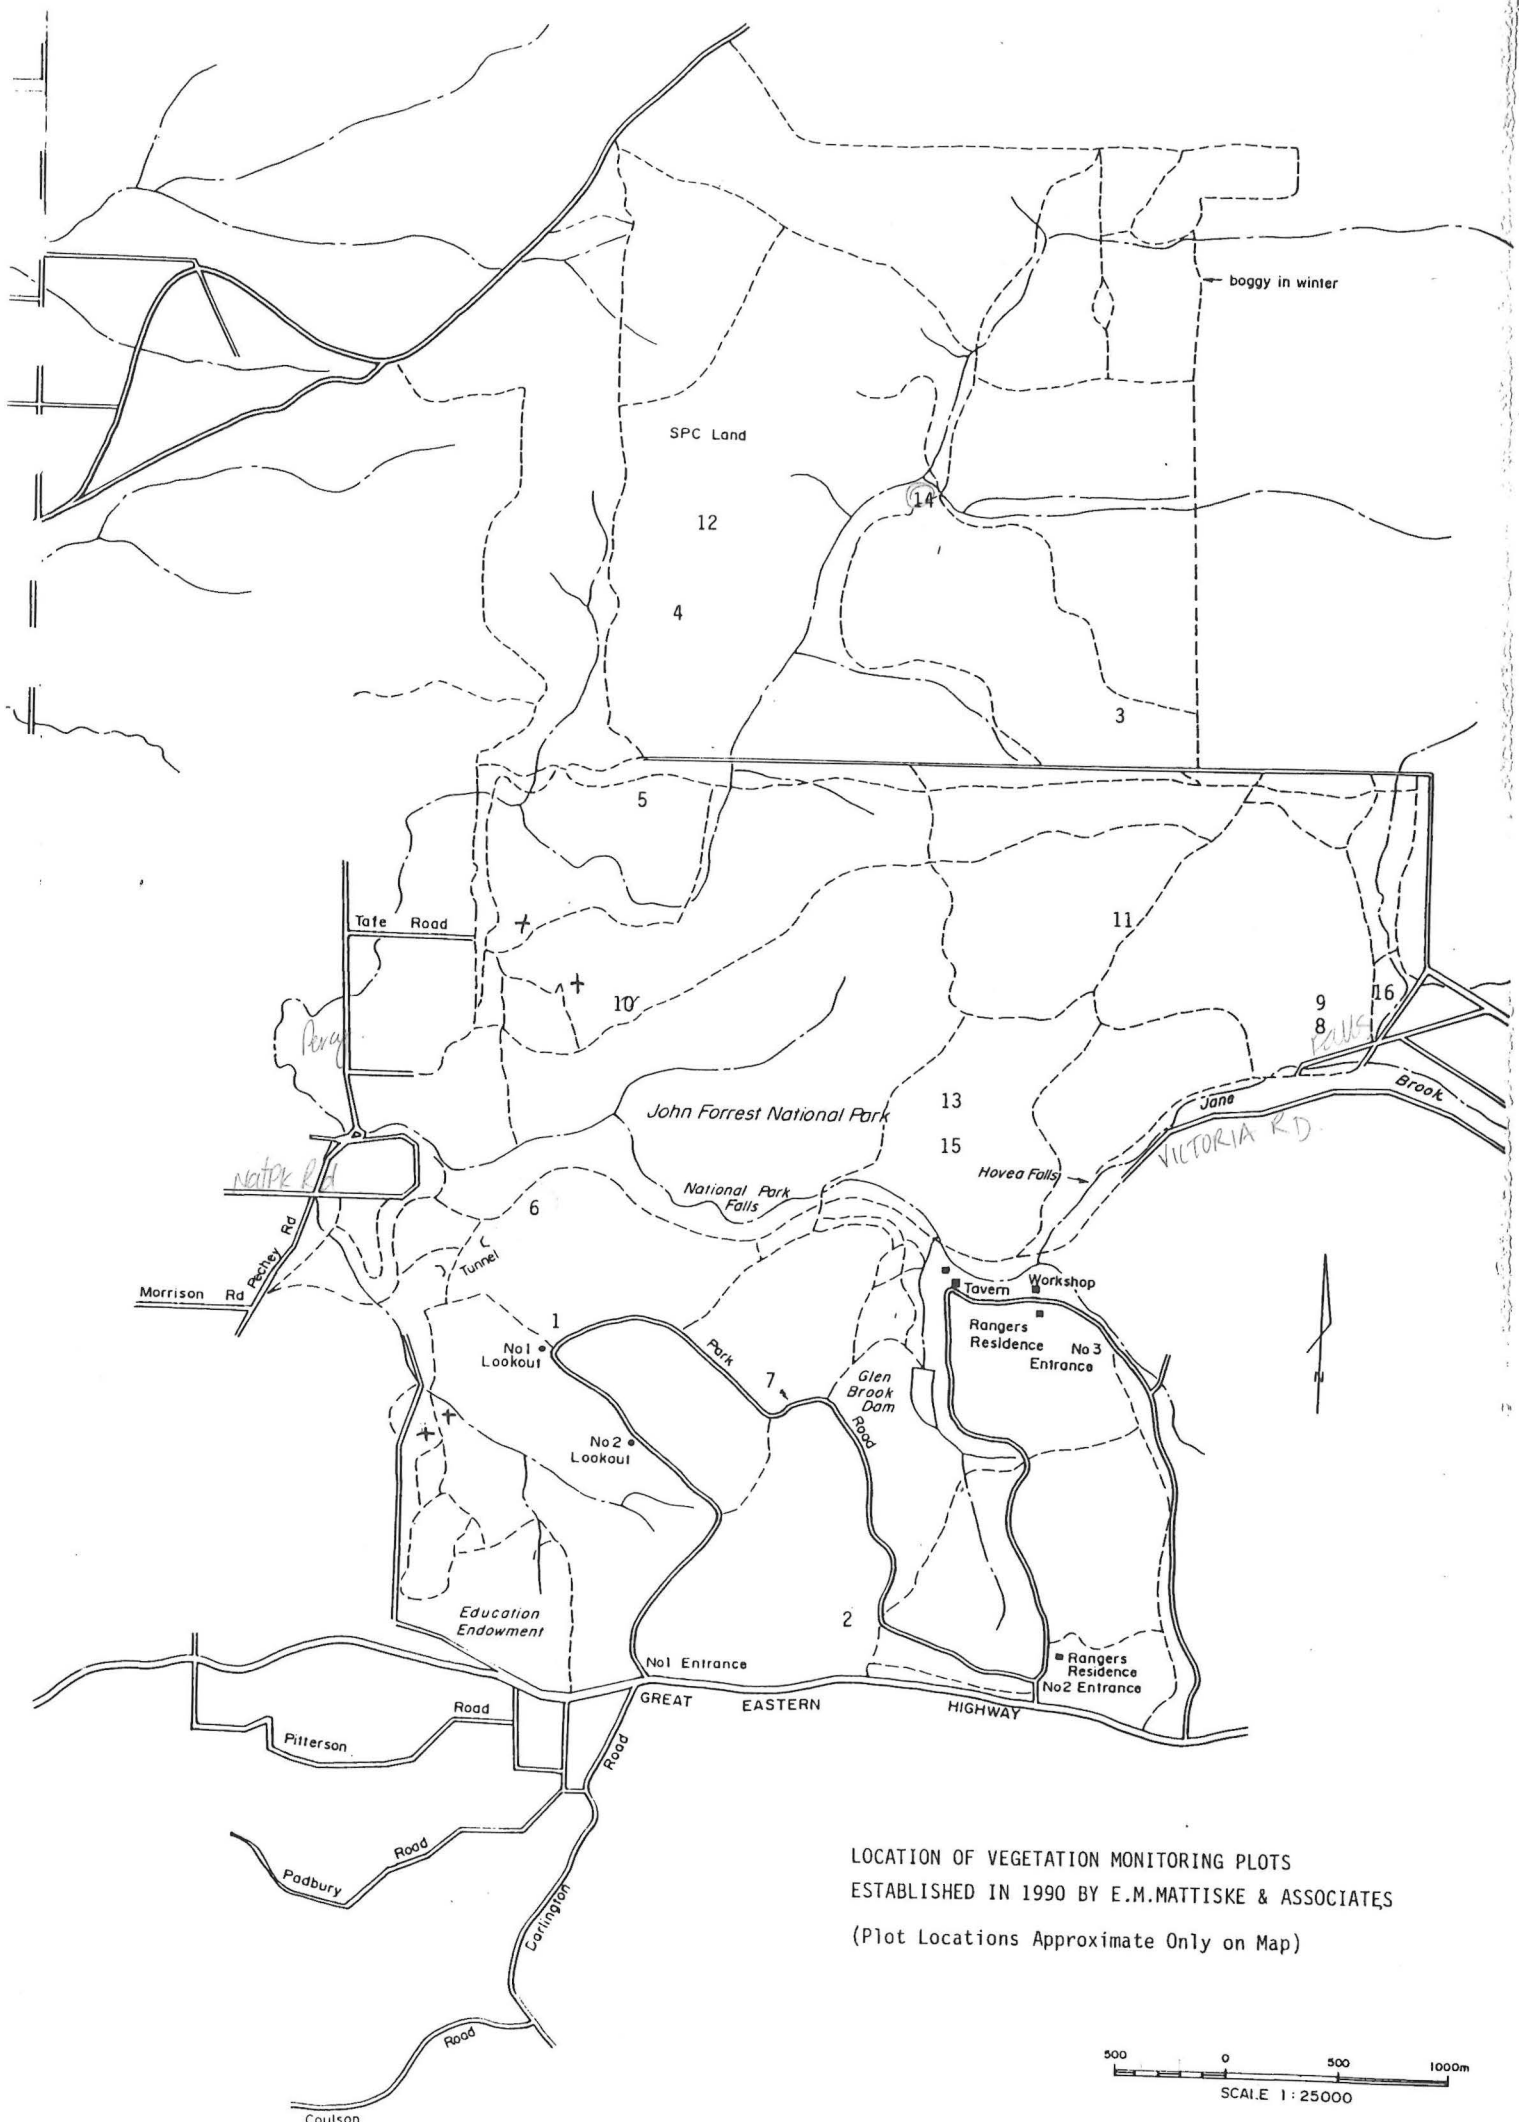

LOCATION OF VEGETATION MONITORING PLOTS  
 ESTABLISHED IN 1990 BY E.M.MATTISKE & ASSOCIATES  
 (Plot Locations Approximate Only on Map)

500 0 500 1000m  
 SCALE 1:25000













# MAP 253

PRIMARY RECTANGLE PERTH BG34

SCALE 1:20,000

Metres 500 1000 1km

- |                           |   |                    |   |                        |   |
|---------------------------|---|--------------------|---|------------------------|---|
| AMBULANCE STATION .....   | * | CARAVAN PARK ..... | Ⓢ | GUIDE HALL .....       | + |
| BOAT RAMP .....           | Ⓡ | CAR PARK .....     | Ⓟ | HOSPITAL .....         | + |
| BOAT FUELLING POINT ..... | Ⓡ | CYCLEWAY .....     | Ⓢ | LIBRARY .....          | + |
| BOWLING CLUB .....        | Ⓡ | GOLF COURSE .....  | Ⓢ | PLACE OF WORSHIP ..... | + |

JOINS MAP 233



COPYRIGHT © UNIVERSAL PRESS PTY LTD (PUBLISHER) 1995

Travelling



can provide you with Maps and  
Street Directories covering Australia



POLICE STATION ..... ★ PUBLIC COLLEGE ..... G SHOPPING CENTRE ..... J  
 POST OFFICE ..... ☒ PUBLIC SCHOOL ..... S TELEPHONE ..... T  
 PRIVATE COLLEGE ..... C ROUNDABOUT ..... O TRAFFIC LIGHTS ..... L  
 PRIVATE SCHOOL ..... S SCOUT HALL ..... A DISTANCE FROM GPO ..... 2

PRIMARY RECTANGLE PERTH BG34

SCALE 1:20,000

Metres 500 1000 1km

MAP 254

JOINS MAP 234



JOINS MAP 274

COPYRIGHT © UNIVERSAL PRESS PTY LTD (PUBLISHER) 1995



EST. 1897

**S. B. DEVENISH & SONS**

REAL ESTATE & BUSINESS AGENTS

• Sales & Settlements • Auctions & Insurance  
 • Property • Strata Management

187 James St, Guildford WA 6055

**Ph: (09) 378 1555**


Fax: 378 1356 - Mobile: 018 917 236



# MAP 233

PRIMARY RECTANGLE PERTH BG34

SCALE 1:20,000

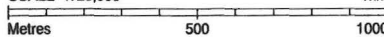


- AMBULANCE STATION .....
- BOAT RAMP .....
- BOAT FUELLING POINT .....
- BOWLING CLUB .....

- CARAVAN PARK .....
- CAR PARK .....
- CYCLEWAY .....
- GOLF COURSE .....

- GUIDE HALL .....
- HOSPITAL .....
- LIBRARY .....
- PLACE OF WORSHIP .....

JOINS MAP 213

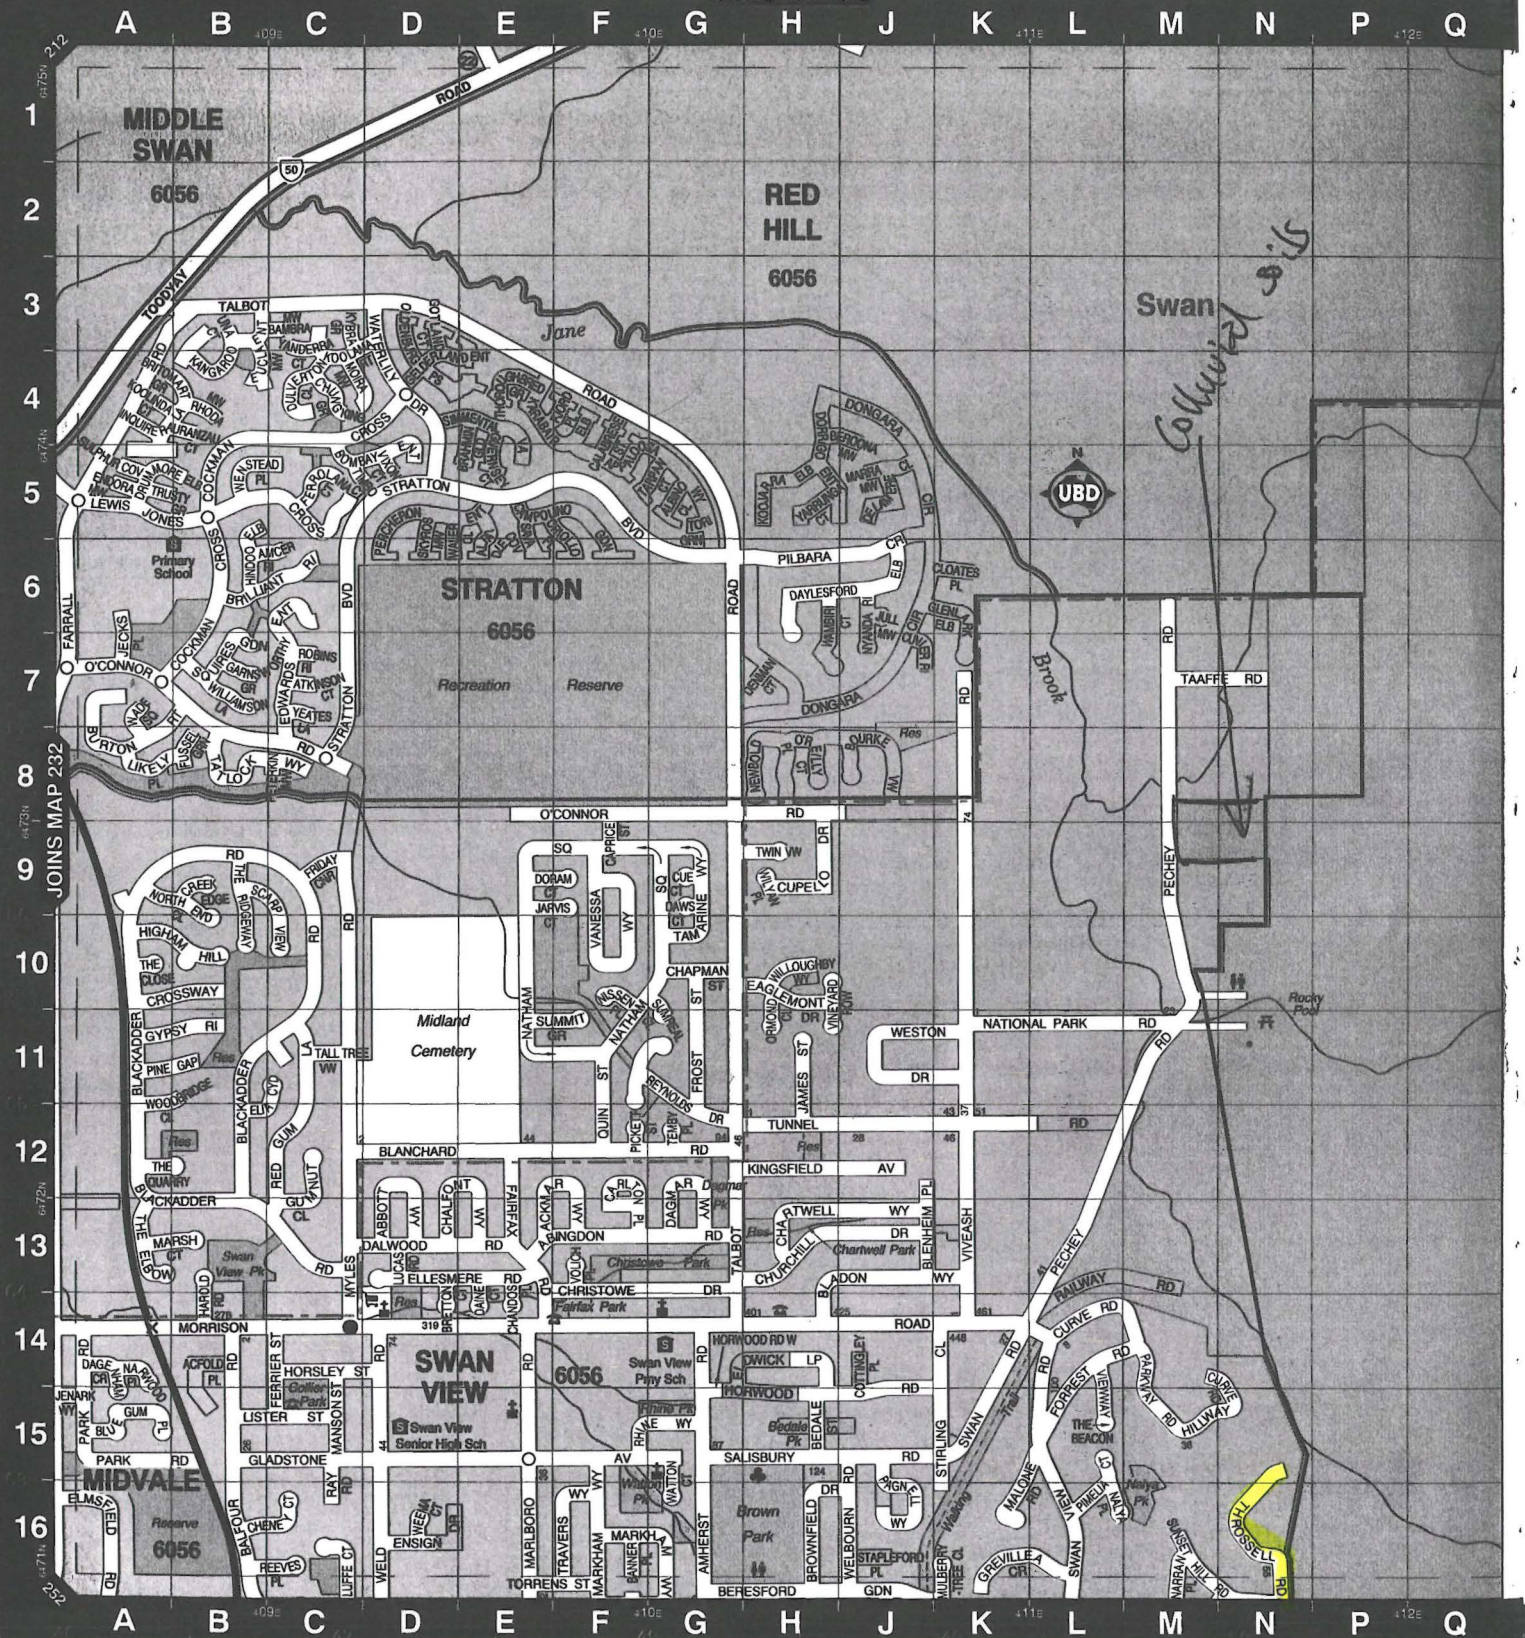

COPYRIGHT © UNIVERSAL PRESS PTY LTD (PUBLISHER) 1995

JOINS MAP 253

**Australian  
Housing & Land**  
Excellence in residential development

**"FORREST  
VIEW  
ESTATE"**

**A Superb Brand New Residential Estate**

Enquiries: Peter Lyon

Phone: (09) 345 1877 All Hours: (09) 480 9283

*"On the hill's side of Stratton"*



POLICE STATION ..... ★  
 POST OFFICE ..... ✉  
 PRIVATE COLLEGE ..... ①  
 PRIVATE SCHOOL ..... ②

PUBLIC COLLEGE ..... ③  
 PUBLIC SCHOOL ..... ④  
 ROUNDABOUT ..... ⑤  
 SCOUT HALL ..... ⑥

SHOPPING CENTRE ..... ⑦  
 TELEPHONE ..... ⑧  
 TRAFFIC LIGHTS ..... ⑨  
 DISTANCE FROM GPO ..... ⑩


PRIMARY RECTANGLE PERTH BG34

SCALE 1:20,000

Metres 500 1000 1km

MAP 234

JOINS MAP 214

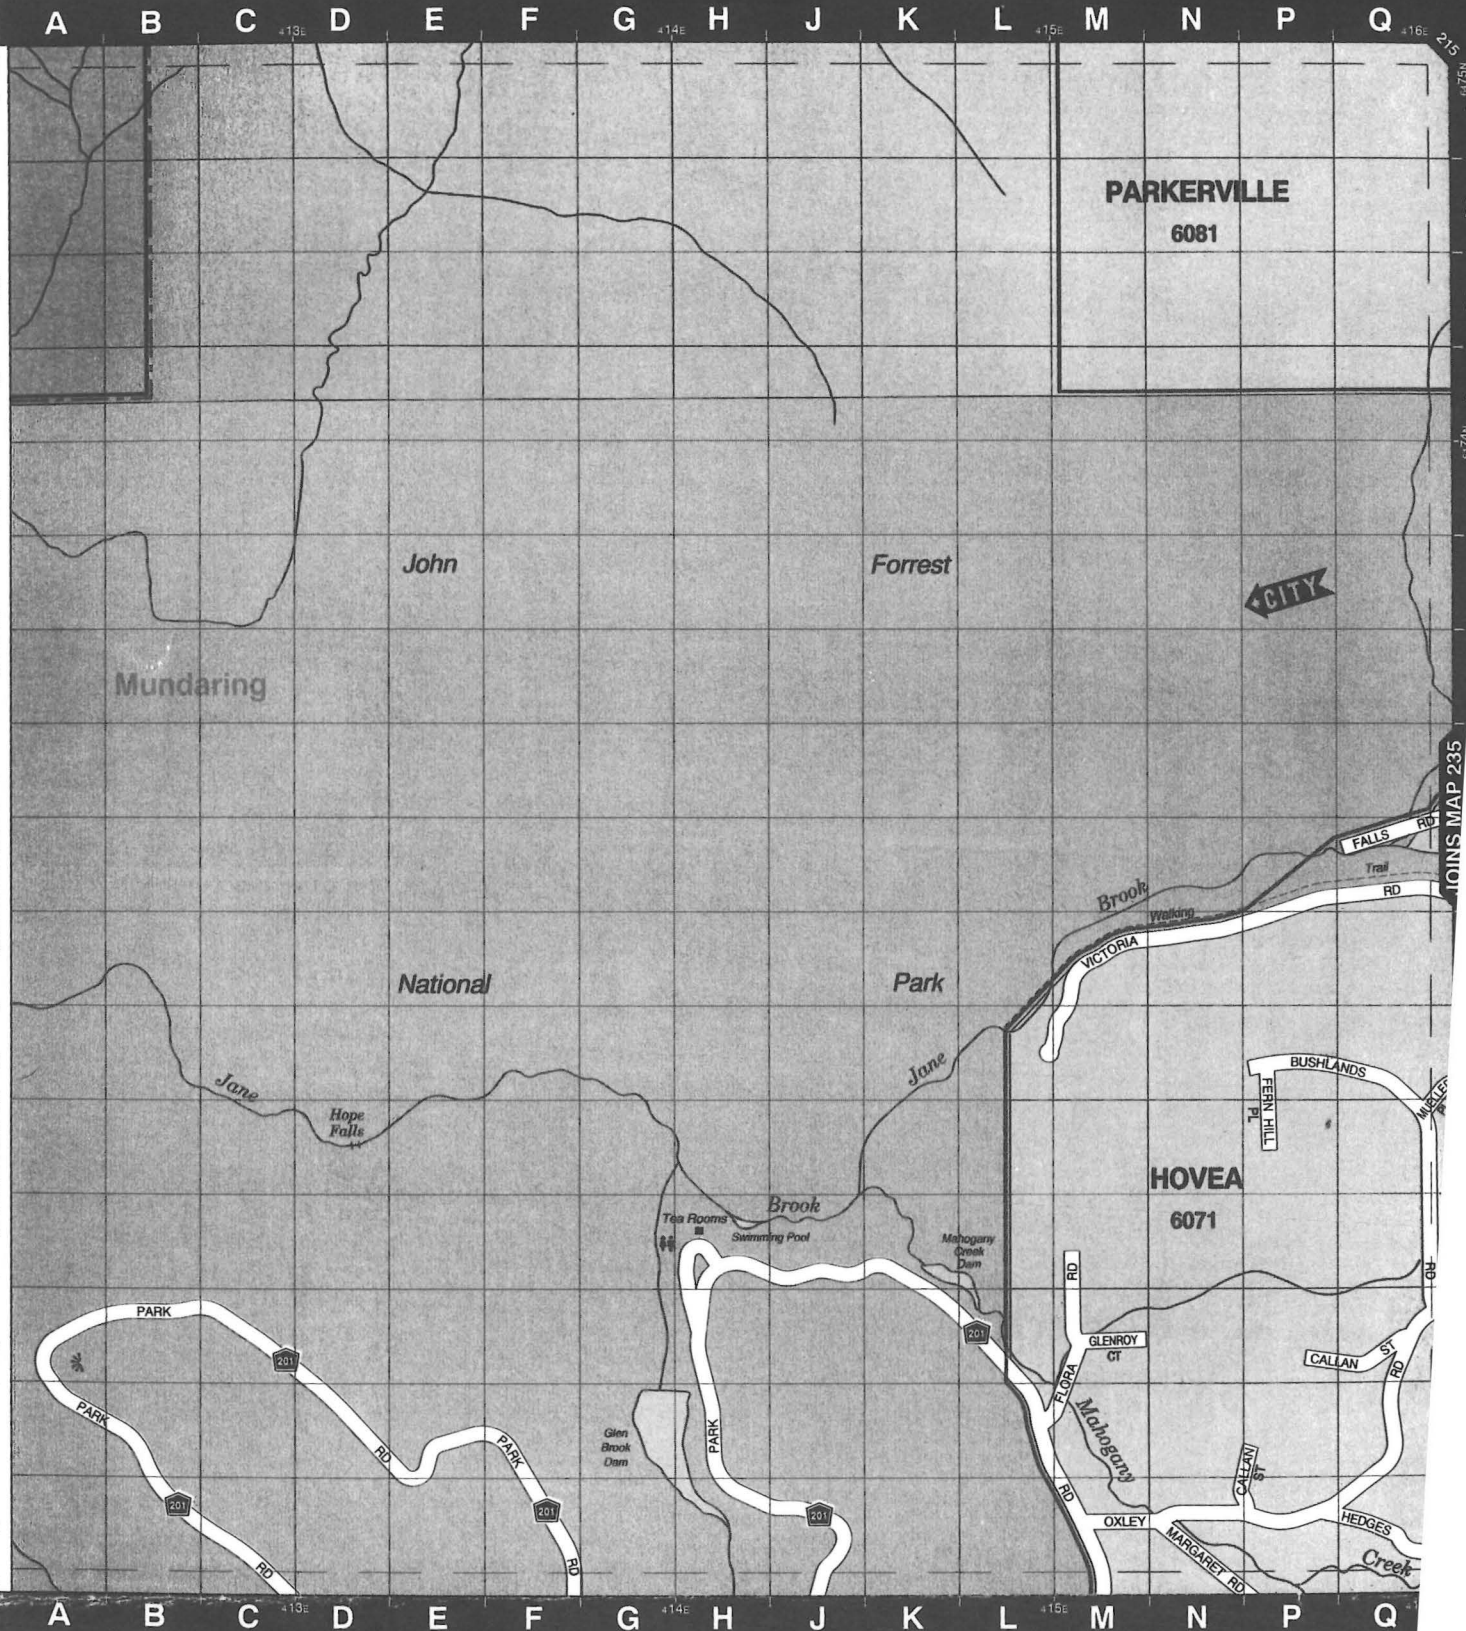

JOINS MAP 254

COPYRIGHT © UNIVERSAL PRESS PTY LTD (PUBLISHER)


THE KEY TO A PLACE YOU CAN CALL YOUR OWN IN ....

**STRATTON**

Hundreds of homesites in  
 many key suburbs unlocked!  
 call **222 4835**





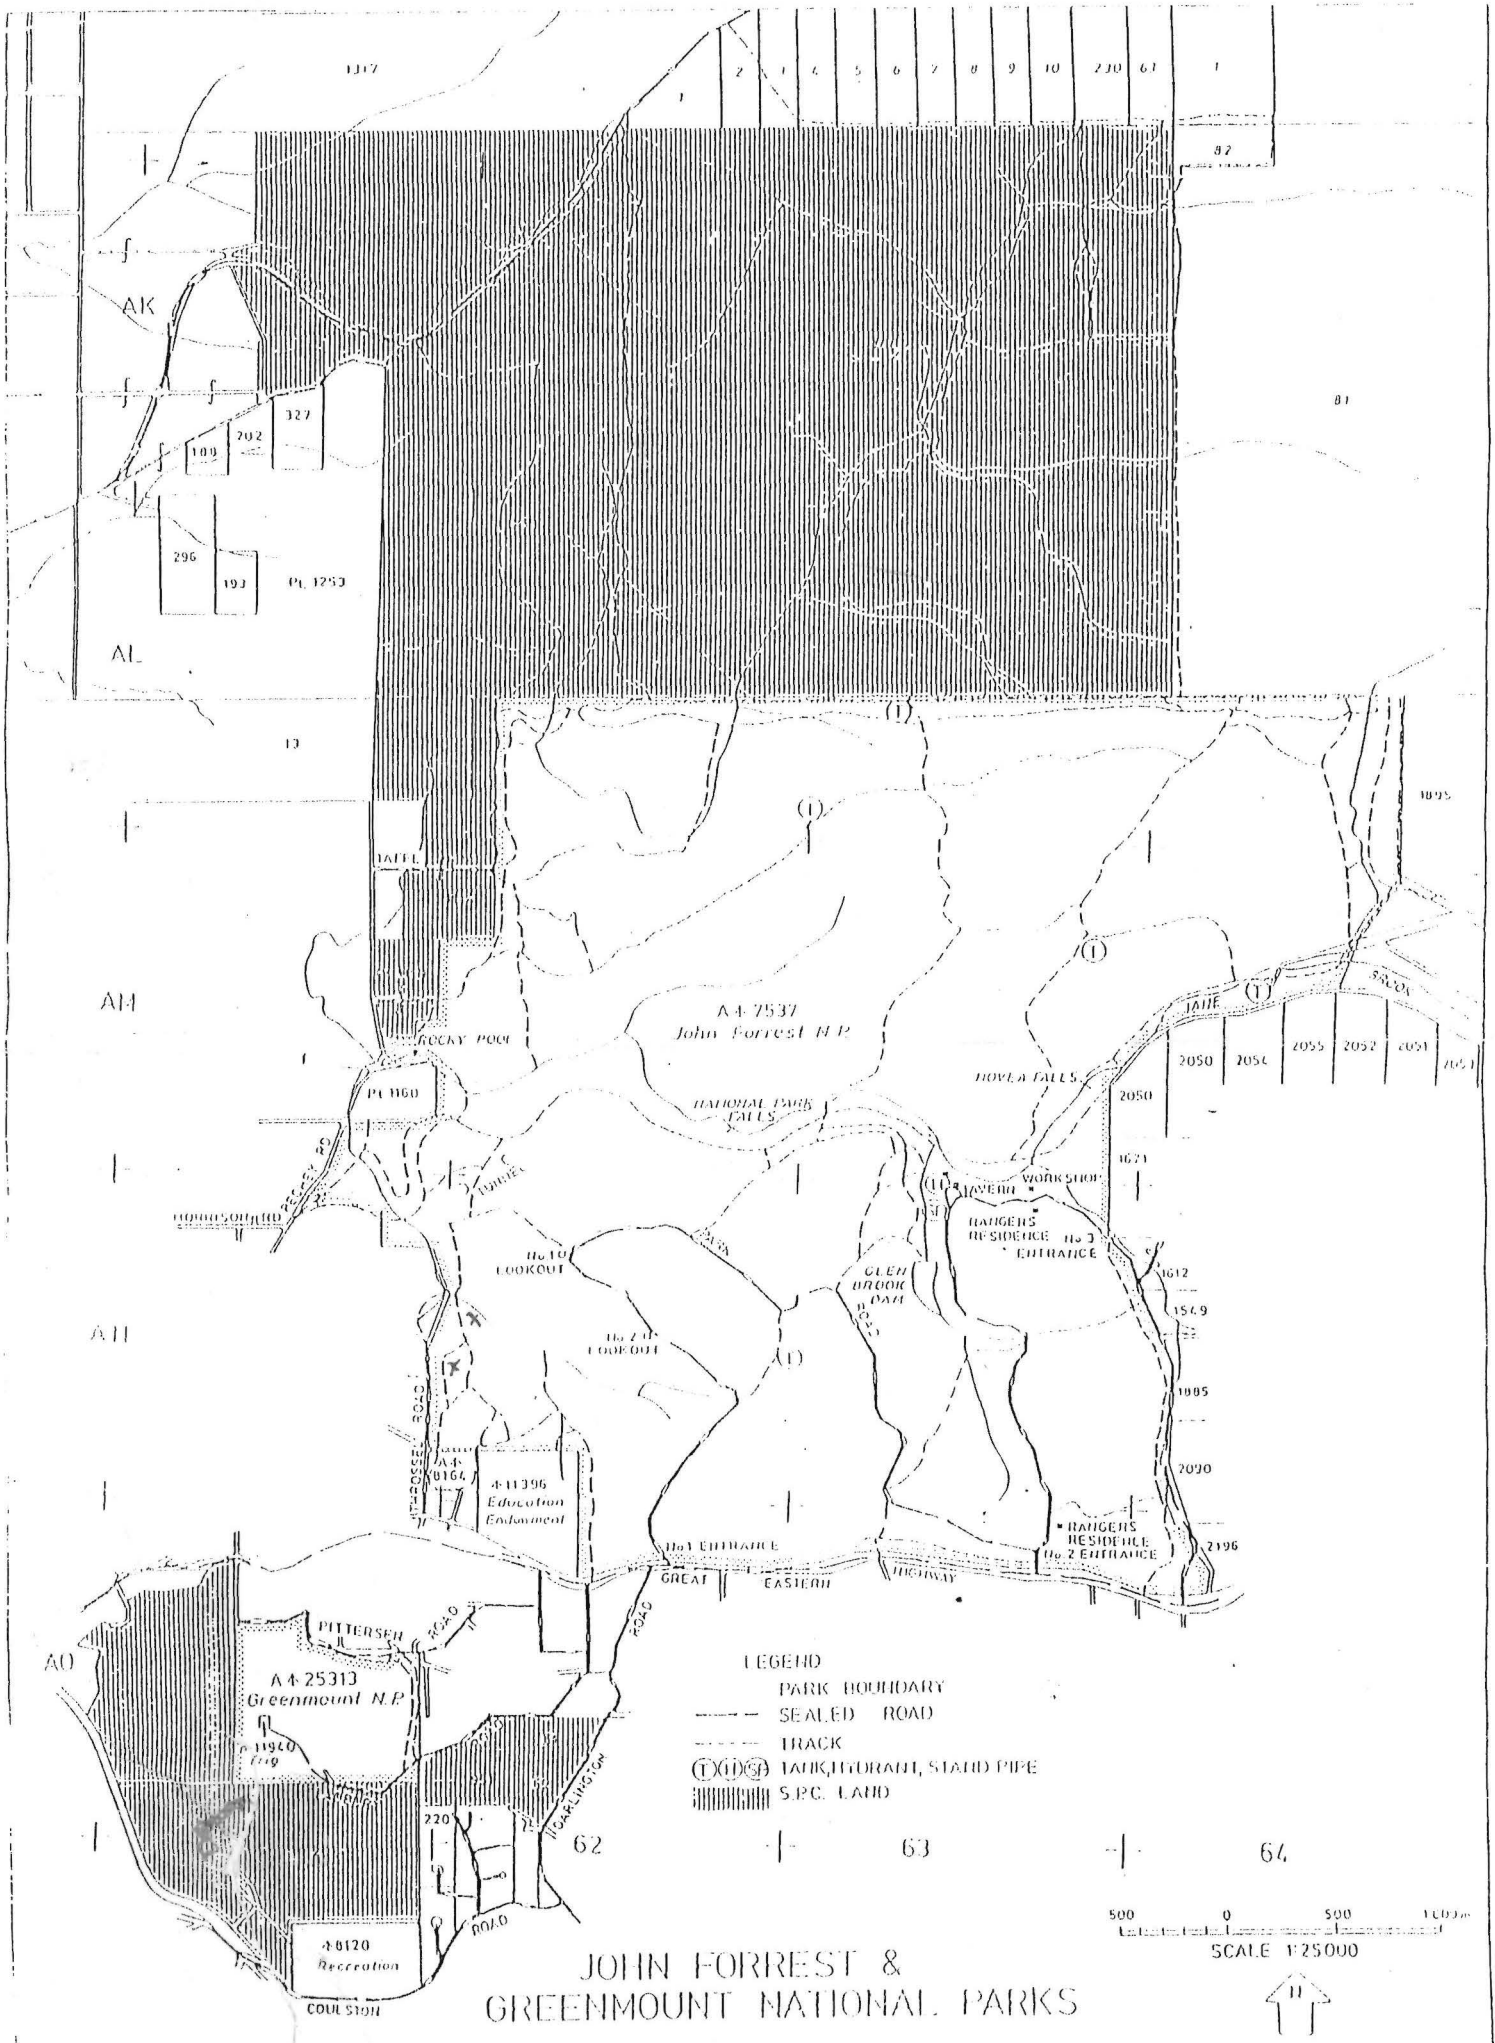



ph: 310 9845.  
64 Winthrop Dr  
Winthrop

Lead Hwy exit  
Fwy

(W) (Free)

Risley (R)  
next lights off Risley  
(L) Winthrop.

Randabau /  
Pine park  
right HS  
road

Lauren L  
Hill View R  
Holder R  
Winick R  
Pitt L