## RESERVE ACTION SHEET: CONSERVATION RESERVES

RESERVE No. 16942

LOCAL GOVERNMENT: Shire of Kulin

NAME: Unnamed

PURPOSE: Conservation of Flora & Fauna VESTING: Conservation Commission of WA

## **ACTION**

Change of purpose from "Water Supply" to "Conservation of Flora & Fauna"

TOTAL AREA: 13.5465ha

## **REASON FOR ACTION**

Reserve 16942 is located in the Dudinin Townsite. It originally had an area of 42.7109ha and was vested in the Water Corporation for the purpose of "Water Supply". It is one of many water reserves in the Wheatbelt Region that were identified several years ago as being surplus to the requirements of the water agencies. The northern section of the reserve (29.1673ha) contains a dam and sporting facilities. This area has been excised from Reserve 16942 and set aside as a separate reserve (Reserve 46697) vested in the Shire of Kulin for the purpose of "Recreation and Landscape Protection". The remaining southern portion of Reserve 16942 had been identified as having sufficient conservation value to warrant nature reserve status. This area has remained designated as Reserve 16942 but with a change of purpose to "Conservation of Flora & Fauna" with vesting in the CCWA


Customer advice: p. 14 Proposal Summary: see pp.


**IUCN classification**: (if existing reserve)

Recommended IUCN classification: (if new reserve) la

**NATIVE TITLE:** Extinguished by previous vesting (Ward High Court decision)

1	LAND SERVICES CO-ORDINATOR	To note	50
2	LAND & EXTERNAL FUNDING UNIT	Send copies of advice and maps to:	
		<ul> <li>Lisa Wright (Woodvale)</li> </ul>	
		<ul> <li>District Manager Great Nouther</li> <li>Regional Manager Wheathelt</li> </ul>	
		<ul> <li>Regional Manager Wheathelt</li> </ul>	
		Attach TENIS gazettal history to file 1717	to
		Add report to Conservation Commission summary	
3	SENIOR POLICY OFFICER, P.V.S.	To note re native title	
4	SENIOR POLICY OFFICER, CRAWLEY (for purchases)	To note	NA
5	DIRECTOR, NATURE CONSERVATION/ -DIRECTOR, PARKS AND VISITOR SERVICES	To note	
6	C.I.S.	Please rename file/create new file	
7	LAND & EXTERNAL FUNDING UNIT	Delete from District Proposals spreadsheet	

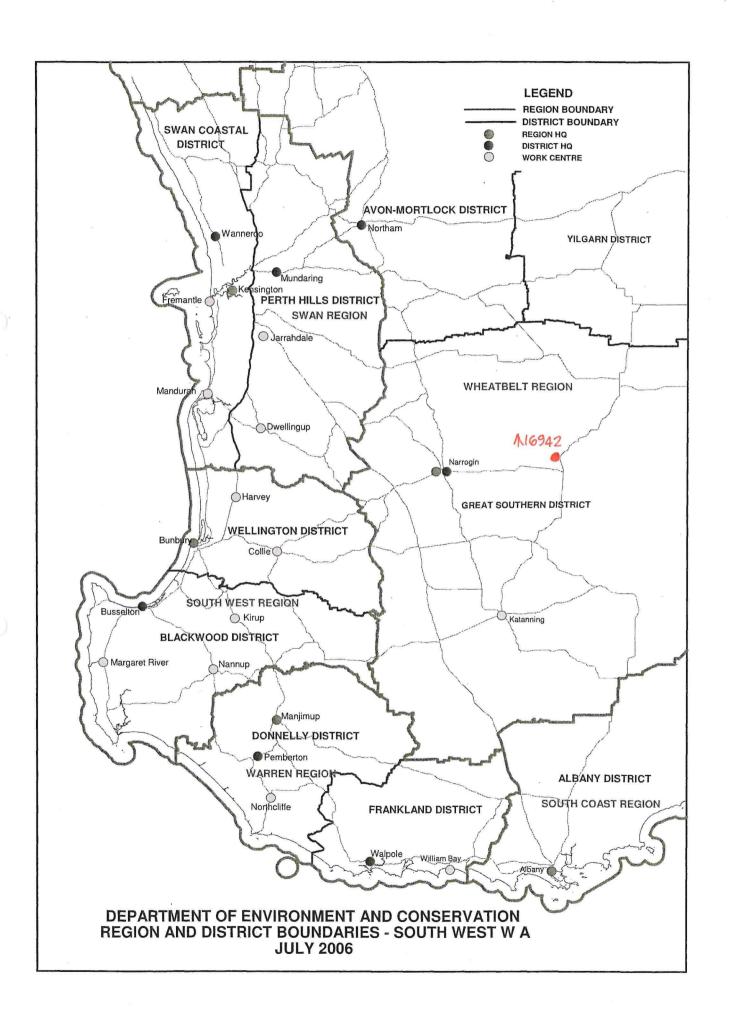

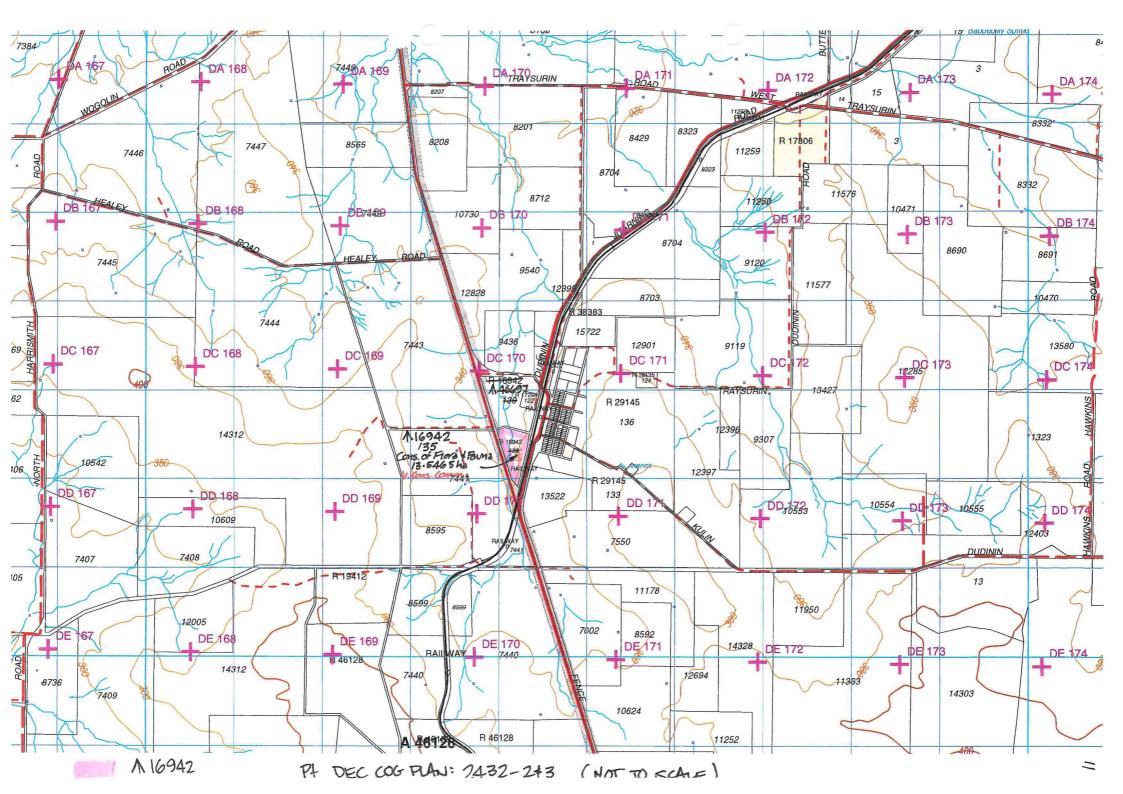

AMENDMENTS Amend. A16942 - Gaz 16/5/86 pg 1663 PLAN 4061(2) DUDININ TOWNSITE 17294 122 DIA. 46124 A 46697 270° 0 134 42.7109 ha. 29.1673 ha. 283°26' ENLARGEMENT AT (A) SCALE 1:750 206° 34' 6 153°26 ₼ 16942 135 13.5465 ha. AMENDMENT APPROVED
(ADDITION OF LOTS 134,135) Authorised Land Officer 15/11/402001 Date DP 187278 FILE No. 535 - 18 134,135 DUDININ LOTS <del>130</del> (<del>M 16942)</del> LAND DISTRICT WILLIAMS SCALE All measurements in metres 1: 5000 SURVEY APPROVED SURVEYOR'S CERTIFICATE Calc. Bk. No. F. S. Beahan B Fol. 50 I hereby certify that this survey was perforor assumed from O.P. Narrogin 988 med by me personally (or under my personal Date 17 supervision, inspection and field check), in strict accordance with the Licensed Surveyors Examined Public Plan. K.E.C. 28/5/86 (Guidence of Surveyors) Regulations, Registers in Key Plan DARDININ Custodia ef Plans
DEPLOF LANDS AND SURVEYS Diagram passed Cedestrel Plan Dudinin 2000 13:03 & Pt 13:04 Reference Dudinin 10 000 3-1 Licensed Surveyor. Diagram Drawn A.P.Leith Date 15-1-1986 DIÁGRAM No. 5.107