

CONSERVATION ESTATE OFFICER
LAND ADMINISTRATION SECTION
PARK POLICY AND TOURISM BRANCH

Reserve 24496 within MIDWEST/MOORA Region/District, was
~~created~~/amended, effective from 23 JUNE 2005.

- A copy of the customer advice can be found at folio 56.
The ~~addition~~ / excision / ~~amendment~~ is shown on the associated Deposited Plan / Diagram which is listed below:

Deposited Plan 218516 lot / location 12793/4 folio 65-68 incl.

Other relevant deposited plans / diagrams:

_____ lot / location _____ folio _____

- A locality plan with the addition / excision / amendment shown highlighted can be found at folio 69.
- Copies of other relevant notifications pertinent to this reserve action have been placed at folios 70.

Would you please advise the relevant offices of this amendment through your Reserve Action Sheet.


Recommended IUCN classification 1a (no change)

[Signature]

Program Leader
Tenure Group, GIS
Information Management Branch

28/7/06



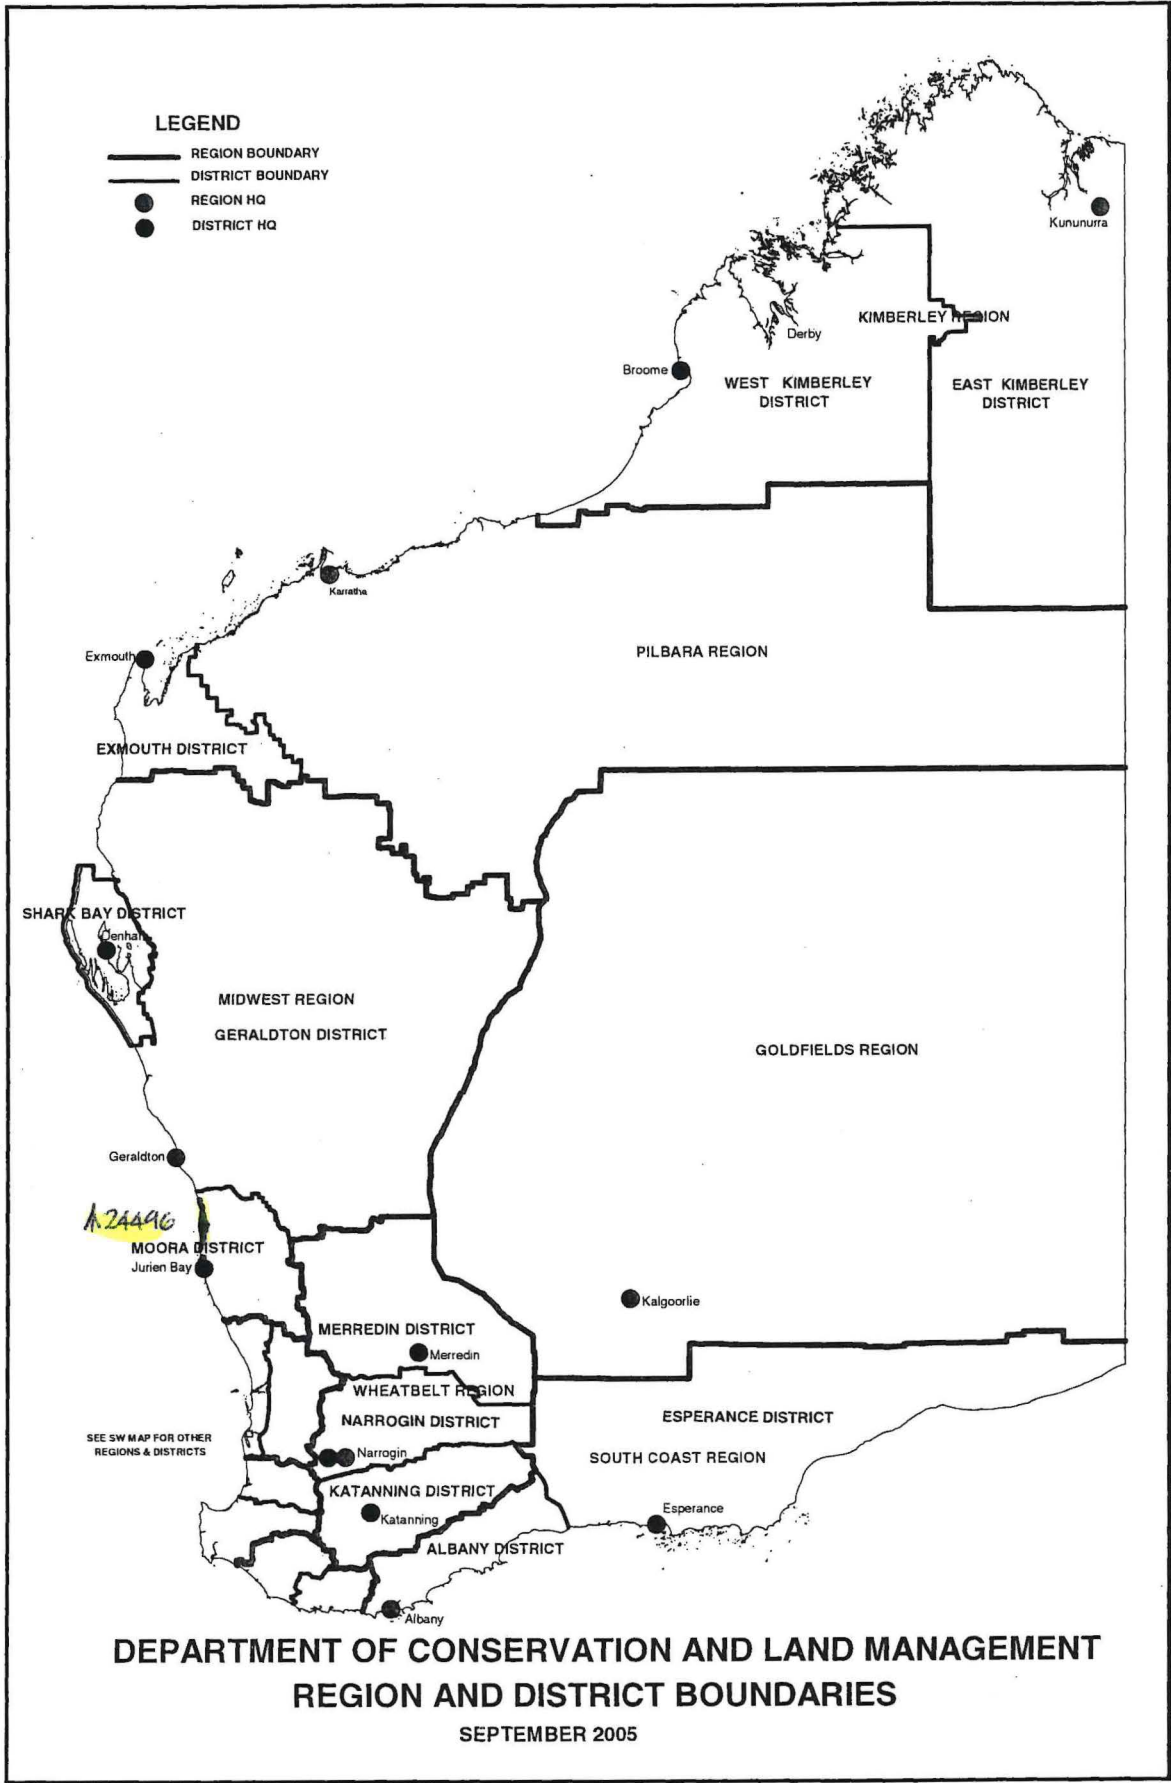

See p. 16.

CIS: pls send 2005F001496V01 and 2005F001966V01 to VFL with this.

Customer Advices for Reserve Actions 1/10/2005 - 31/10/2005

Shire of Irwin 1/10/2005 - 31/10/2005


Reserve No.	Land Description	DOLA File No.	Volume/Folio	Action	Document No.	Registered	Street Name	Area	Public Plans
24496	Lot 9759 on Deposited Plan 39607	00144-1969-02RO	3074-20	Amendment of Reserve to To exclude land now identified as Lots 12793 and 12794 on Deposited Plan 218516 and the area being reduced to 66503.7582 hectares.	J333114	23/06/2005	Indian Ocean Drive	66503.7582 Ha	BEHARRA 1:50000
	Lot 12174 on Deposited Plan 39607		3110-928						
	Lot 11888 on Deposited Plan 39607		3090-515						
	Lot 12175 on Deposited Plan 39607		3110-929						
	Lot 12176 on Deposited Plan 39607		3110-930						
	Lot 12177 on Deposited Plan 39607		3110-931						
	Lot 12178 on Deposited Plan 39607		3110-932						
	Lot 12179 on Deposited Plan 39607		3110-933						
	Lot 12799 on Deposited Plan 39607		3133-22						
	Lot 12800 on Deposited Plan 39607		3133-23						
	Lot 12801 on Deposited Plan 39607		3133-24						
	Lot 12802 on Deposited Plan 39607		3133-25						
	Lot 12803 on Deposited Plan 39607		3133-26						
	Lot 12804 on Deposited Plan 39607		3133-27						
	Lot 12805 on Deposited Plan 39607		3133-28						
	Lot 12806 on Deposited Plan 39607		3133-29						
	Lot 12810 on Deposited Plan 39607		3133-149						
	Lot 12811 on Deposited Plan 39607		3133-150						
	Lot 12812 on Deposited Plan 39607		3133-151						
	Lot 12817 on Deposited Plan 39607		3133-387						

2005F001966V01
SERIAL NO: 2005F001966V01

DEPARTMENT OF CONSERVATION & LAND MANAGEMENT
2 1 NOV 2005
KENSINGTON WA

Pls prepare plans for 24496.
Thanks, Vin. 2/11/05
JLF



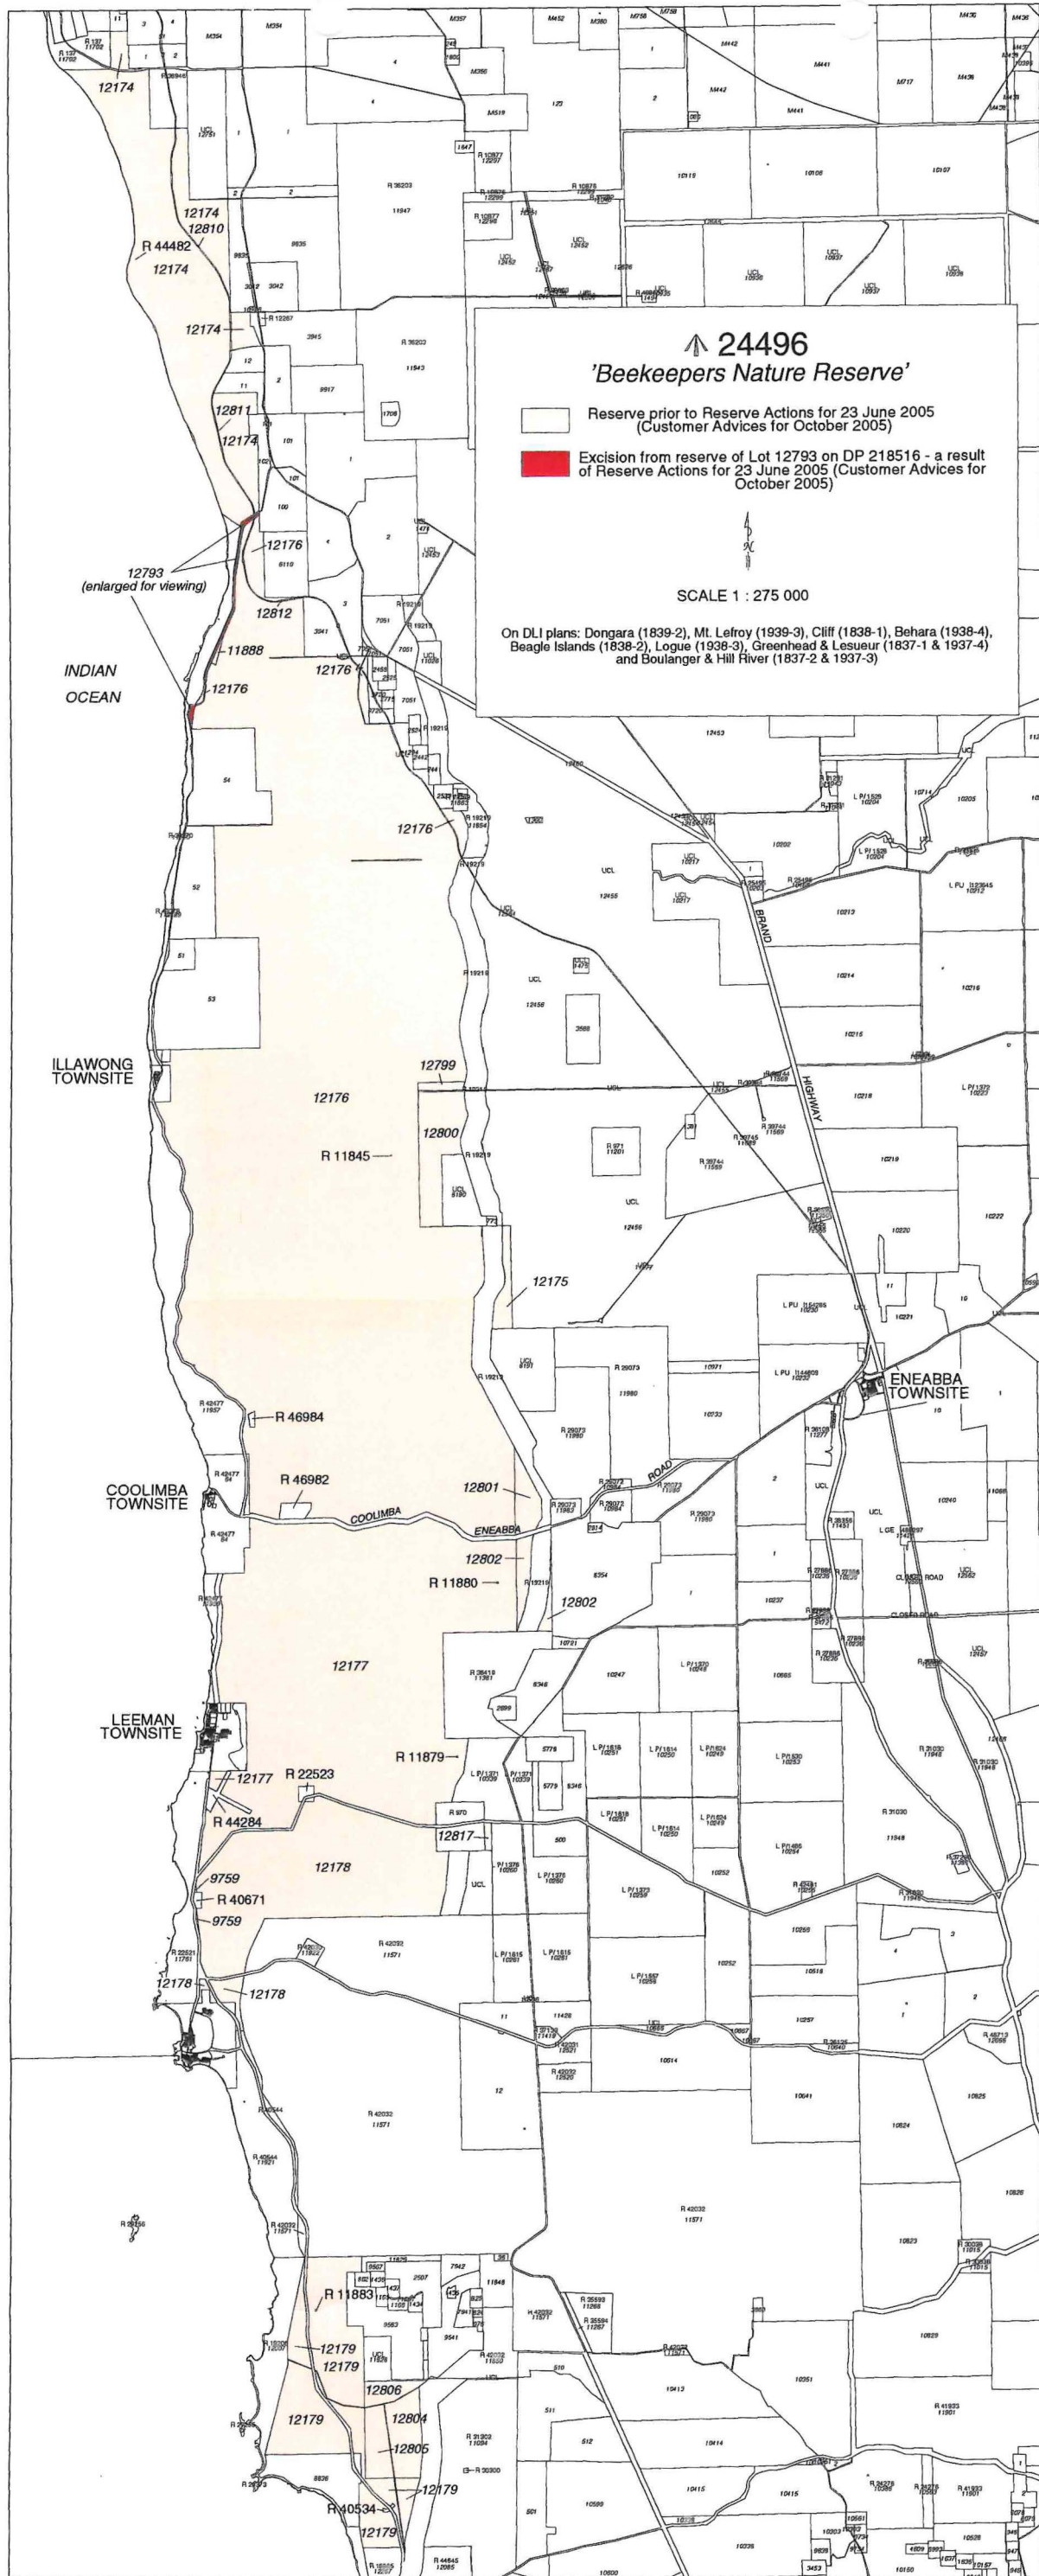

24496
'Beekeepers Nature Reserve'

- Reserve prior to Reserve Actions for 23 June 2005 (Customer Advices for October 2005)
- Excision from reserve of Lot 12793 on DP 218516 - a result of Reserve Actions for 23 June 2005 (Customer Advices for October 2005)

SCALE 1 : 275 000

On DLI plans: Dongara (1839-2), Mt. Lefroy (1939-3), Cliff (1838-1), Behara (1938-4), Beagle Islands (1838-2), Logue (1936-3), Greenhead & Lesueur (1837-1 & 1937-4) and Boulanger & Hill River (1837-2 & 1937-3)

12793
(enlarged for viewing)

INDIAN OCEAN

ILLAWONG TOWNSITE

COOLIMBA TOWNSITE

LEEMAN TOWNSITE

ENEABBA TOWNSITE

AVON RIVER

COOLIMBA

ENEABBA

ROAD

CLOSED ROAD