

## RESERVE ACTION SHEET - CONSERVATION RESERVES

RESERVE No. **29901**

### REASON FOR ACTION

- Addition to CALM Estate of a Class "C" Reserve vested in the NPNCA for the purpose of "Conservation Park", (formerly "Picnic Ground", vested in the Shire of Dandaragan). Area: 2.1625 ha.
- Reserve abuts Reserve 41933 (Coomallo Nature Reserve). Action is in accordance with recommendation in the Lesueur National Park and Coomallo Nature Reserve Management Plan. Reserve is to be upgraded and developed to better cater for visitors to the area
- Gazettal date: 9 December 1997 See folios 293, 294
- Plans at folios 295, 296

	OFFICER	ACTION
1	<del>RESERVES</del> <i>SC</i>	<ul style="list-style-type: none"> <li>- Fill in above details _____</li> <li>- Attach copies of gazettal notices to file _____</li> </ul>
2	INDEX CLERK, RECORDS	<ul style="list-style-type: none"> <li>- Index reserve's name _____</li> <li>- Index reserve's number _____</li> </ul>
3	<del>RESERVES</del> CLERK <i>SC</i>	Send copies of gazettal notices and Map to: <ul style="list-style-type: none"> <li>- Clerk, Woodvale _____</li> <li>- District Manager, Moora _____</li> <li>- Regional Manager, Midwest _____</li> </ul>
4	<del>CONSERVATION</del> ESTATE OFFICER	To note: <i>Sharon Colliss 17.2.98</i>
5	LAND ACQUISITIONS OFFICER	To note:
6	MANAGER, PLANNING & VISITOR SERVICES	To note:
7	DIRECTOR, NATURE CONSERVATION/ NATIONAL PARKS	To note:

DOLA File: 00863-1964-01RO.

Reserve No. 27756 (Swan Locations 7749 to 7761 inclusive) being changed from "Government Requirements" to "Parklands".

Public Plan/s: BG34 (2) 25.28 and 25.29 Approach and Hudman Roads

Local Authority: Shire of Mundaring.

DOLA File: 01132-1965-01RO.

Reserve No. 28554 (Kununurra Lot 24) being changed from "Housing (Department of Agriculture)" to "Use and Requirements of the Government Employees' Housing Authority".

Public Plan/s: DH79 (2) 23.17 Mangaloo Street

Local Authority: Shire of Wyndham/East Kimberley.

DOLA File: 04738-1965-01RO.

Reserve No. 28850 (Canning Locations 2114, 2502, 2997, 2998, 3032, 3033 and 4149) being changed from "Drain Reserve" to "Drain".

Public Plan/s: BG34 (2) 21.13 Miller Street

Local Authority: City of Gosnells.

DOLA File: 02144-1968-01RO.

Reserve No. 29901 (Victoria Location 11010) being changed from "Picnic Ground" to "Conservation Park".

Public Plan/s: Coomaloo (50) Brand Highway and Jurien Road

Local Authority: Shire of Dandaragan.

This Reserve is automatically vested in the National Parks and Nature Conservation Authority pursuant to Section 7 of the CALM Act 1984.

DOLA File: 00895-1971-01RO.

Reserve No. 30934 (Avon Location 28430) being changed from "Gravel Pit" to "Gravel".

Public Plan/s: Mears NW (25) Brookton-Kweda Road

Local Authority: Shire of Brookton.

DOLA File: 01477-1974-01RO.

Reserve No. 34063 (Kojonup Location 348) being changed from "Depot Site (M.R.D.)" to "Depot Site".

Public Plan/s: BJ29 (2) 09.16 Bilston Street and Blackwood Road

Local Authority: Shire of Kojonup.

DOLA File: 02921-1989-01RO.

Reserve No. 42008 (Swan Location 11197) being changed from "Recreation" to "Recreation (Off-Road Motor Sports)".

Public Plan/s: Chittering (25) NW Mooliabeenee Road

Local Authority: Shire of Chittering.

DOLA File: 02492-1996-01RO.

Reserve No. 45088 (Swan Location 12665) being changed from "Public Recreation" to "Public Recreation and Drainage".

Public Plan/s: BG35 (2) 06.09 Connaught and Palace Ways

Local Authority: City of Wanneroo.

A. A. SKINNER, Chief Executive.

LE201\*

**LAND ACT 1933**  
**CANCELLATION OF RESERVES**

Made by His Excellency the Governor under Section 37.

The following reserves have been cancelled.

DOLA File: 02776-1976-01RO.

Reserve No: 1351 (Fremantle Lot 1522) "Public Purposes".

Public Plan/s: BG34 (2) 07.13 Stevens Street

Local Authority: City of Fremantle.

DOLA File: 02522-1895-02RO.

Reserve No: 3053 (Perth Suburban Lot 405) "Wesleyan Church".

Public Plan/s: BG34 (2) 12.25 (not charted) Hay Street

Local Authority: City of Perth.

DOLA File: 03240-1897-02RO.

Reserve No: 4943 (Edjudina District) "Camping Ground".

Public Plan/s: Edjudina (250) and Yerilla Townsite near McKinley and McArthur Streets

Local Authority: Shire of Menzies.

1. CIS. Please cancel  
B/Up at page 290  
Thankyou  
S. Collis  
2.1.98  
See b 295-297



---

---

**LAND ADMINISTRATION**

---

---

LA201\*

**LAND ACT 1933**  
**ORDER IN COUNCIL**  
**(REVOCAION OF VESTINGS)**

By the direction of His Excellency the Governor under Section 34B(1), the following Orders in Council and associated Vesting Orders are revoked.

DOLA File: 00226-1901-01RO.

Order in Council gazetted on 22 November 1912 vesting Reserve No. 7693 in the Hon. Minister for Works for the designated purpose of "Mechanics' Institute".

Local Authority: Shire of Yalgoo.

DOLA File: 13420-1904-01RO.

Order in Council gazetted on 5 June 1970 vesting Reserve No. 9644 in the Minister for Water Supply, Sewerage and Drainage for the designated purpose of "Water".

Local Authority: Shire of Yilgarn.

DOLA File: 04523-1911-01RO.

Order in Council gazetted on 6 October 1922 vesting Reserve No. 13410 in the Hon. the Minister for Water Supply, Sewerage and Drainage for the designated purpose of "Sewerage".

Local Authority: City of Fremantle.

DOLA File: 01150-1915-02RO.

Order in Council gazetted on 5 April 1957 vesting Reserve No. 16418 in the Minister for Water Supplies for the designated purpose of "Water".

Local Authority: Shire of Wongan-Ballidu.

DOLA File: 02239-1916-01RO.

Order in Council gazetted on 15 September 1916 vesting Reserve No. 16484 in the Hon. the Minister for Water Supply, Sewerage and Drainage for the designated purpose of "Water".

Local Authority: Shire of Perenjori.

DOLA File: 03679-1902-02RO.

Order in Council gazetted on 2 June 1978 vesting Reserve No. 21662 in George Henry Audley, Arthur Stanley Hills and Brian William Lloyd for the designated purpose of "Agricultural Hall Site".

Local Authority: Shire of Albany.

DOLA File: 02845-1951-01RO.

Order in Council gazetted on 4 December 1959 vesting Reserve No. 23271 in the Manjimup Road Board for the designated purpose of "Hallsite, Recreation and Children's Playground".

Local Authority: Shire of Manjimup.

DOLA File: 00910-1957-01RO.

Order in Council gazetted on 21 June 1957 vesting Reserve No. 24724 in the Chittering Road Board for the designated purpose of "Recreation".

Local Authority: Shire of Chittering.

DOLA File: 02172-1989-01RO.

Order in Council gazetted on 1 October 1993 vesting Reserve No. 25631 in the East Perth Redevelopment Authority for the designated purpose of "Public Park".

Local Authority: City of Perth.

DOLA File: 02037-1961-01RO.

Order in Council gazetted on 5 January 1990 vesting Reserve No. 27073 in the City of Armadale for the designated purpose of "Public Recreation".

Local Authority: City of Armadale.

DOLA File: 04738-1965-01RO.

Order in Council gazetted on 19 September 1975 vesting Reserve No. 28850 in the Metropolitan Water Supply, Sewerage and Drainage Board for the designated purpose of "Drain Reserve".

Local Authority: City of Gosnells.

DOLA File: 00784-1966-01RO.


Order in Council gazetted on 16 February 1990 vesting Reserve No. 29590 in the Shire of Wongan - Ballidu for the designated purpose of "Aerial Landing Ground".

Local Authority: Shire of Wongan-Ballidu.

DOLA File: 02144-1968-01RO.

Order in Council gazetted on 18 March 1977 vesting Reserve No. 29901 in the Shire of Dandaragan for the designated purpose of "Picnic Ground".

Local Authority: Shire of Dandaragan.

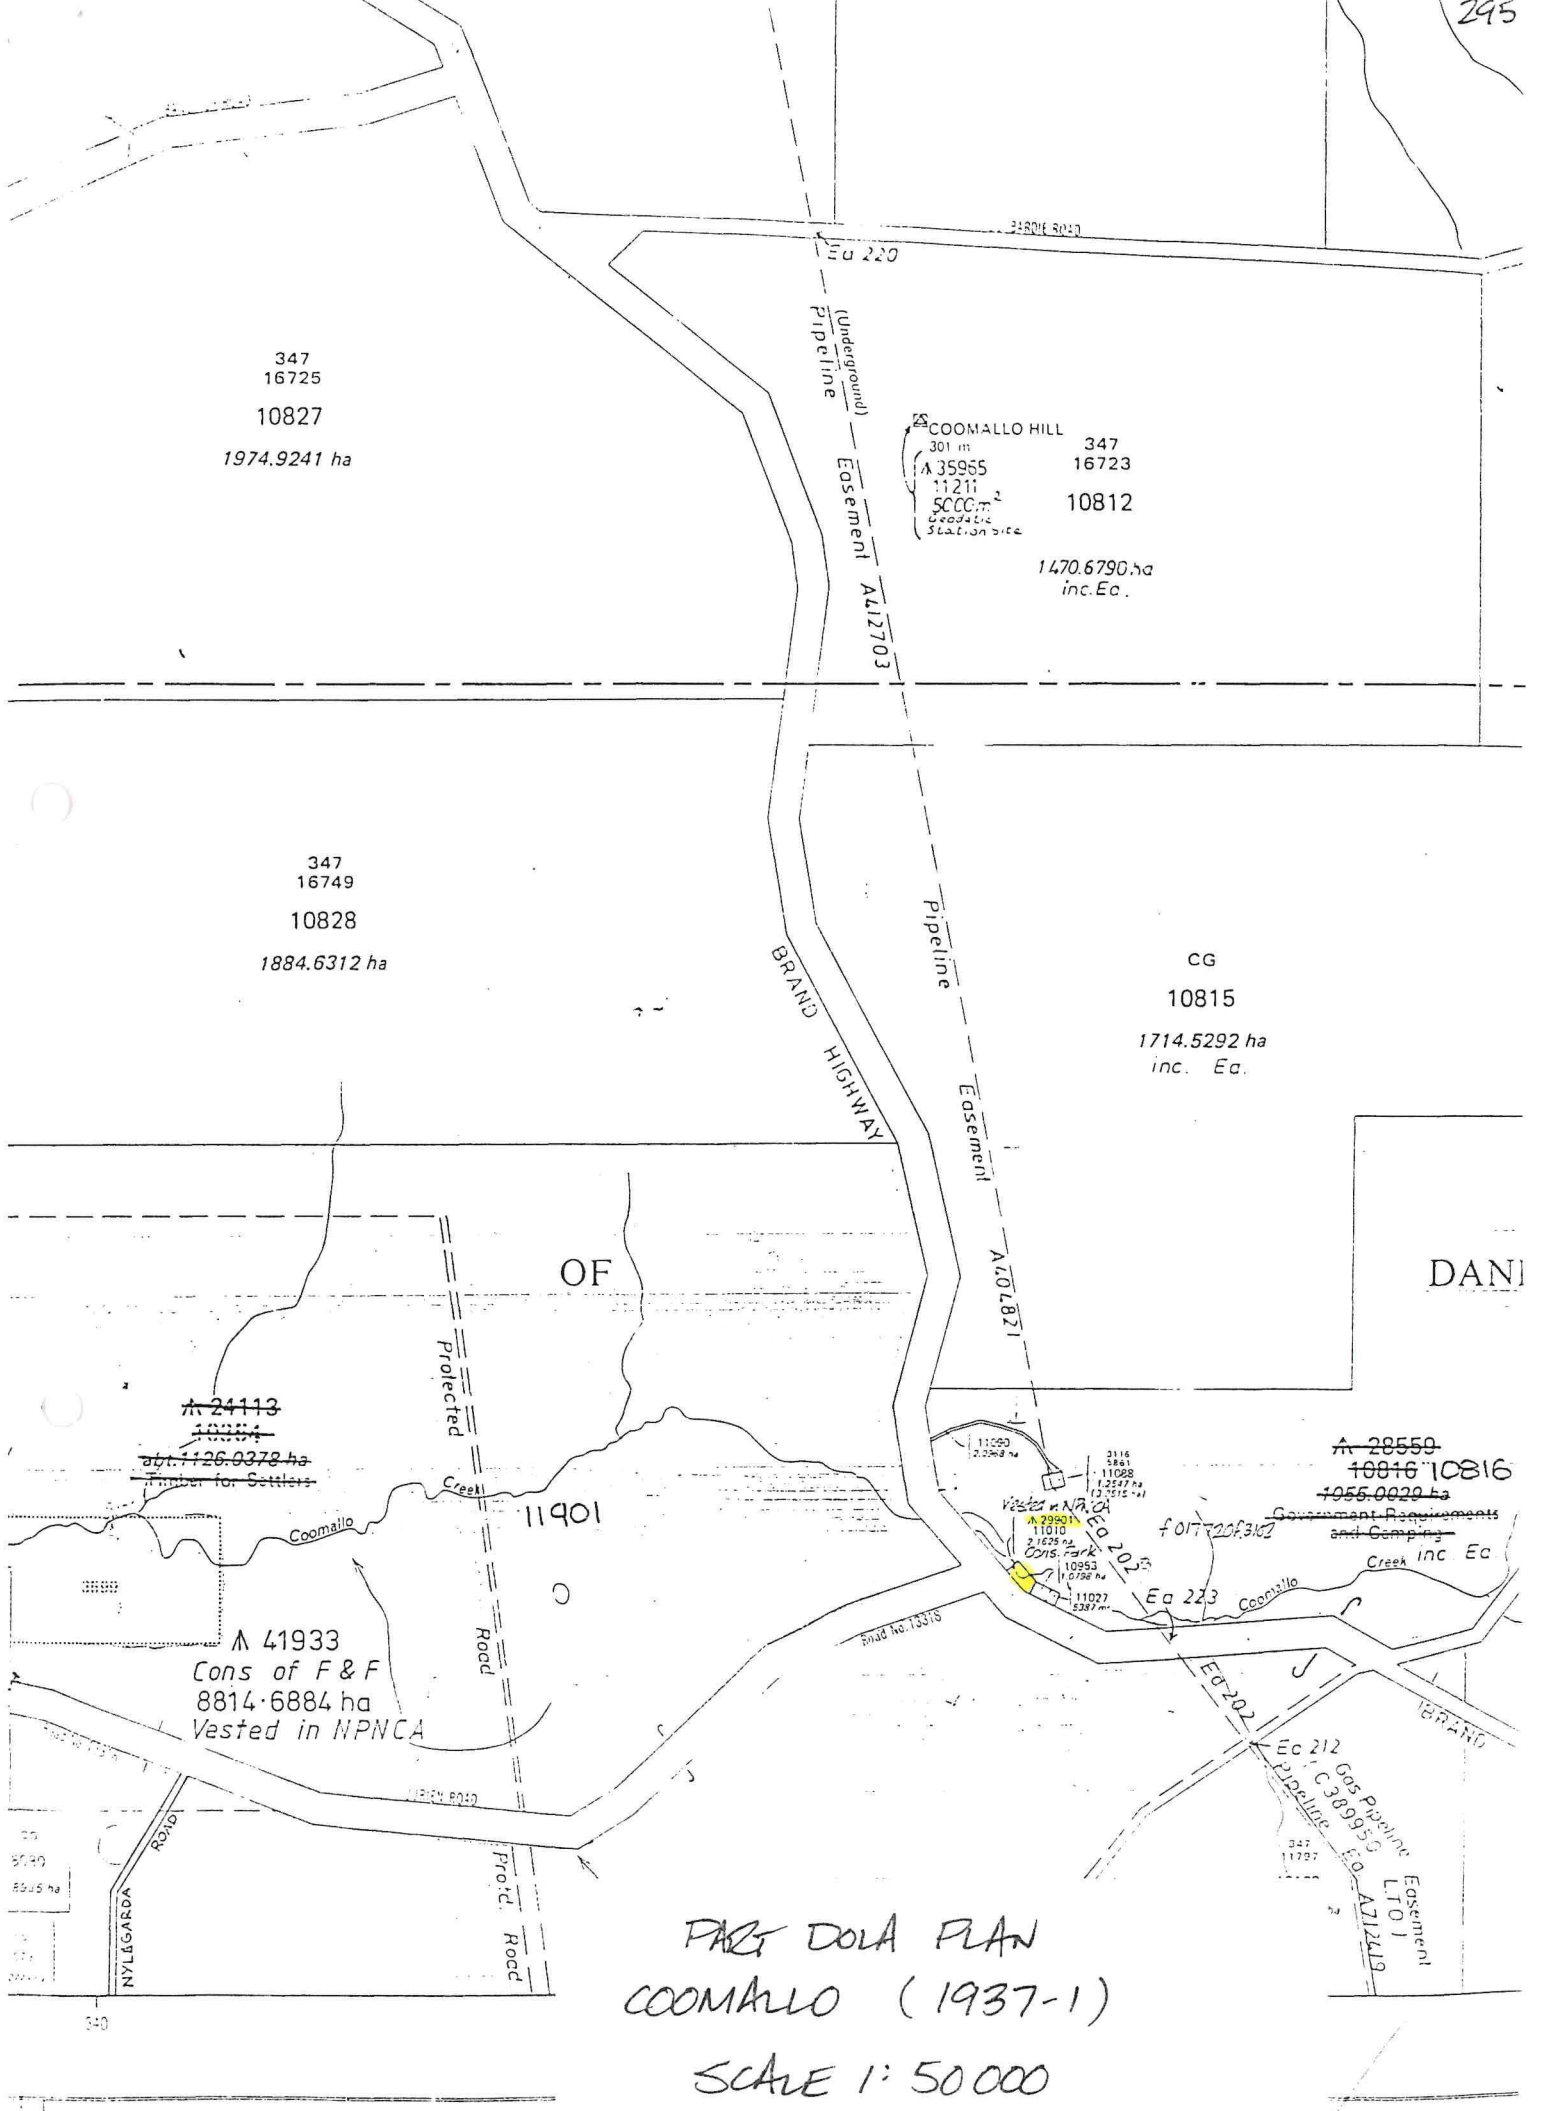

347  
16725  
10827  
1974.9241 ha

COOMALLO HILL  
301 m  
A 35955  
11211  
SCCGm<sup>2</sup>  
Geodetic  
Station site  
347  
16723  
10812  
1470.6790 ha  
inc. Ea.

347  
16749  
10828  
1884.6312 ha

CG  
10815  
1714.5292 ha  
inc. Ea.

A 24113  
~~10334~~  
abt. 1126.0378 ha  
Timber for Settlers

A 41933  
Cons of F & F  
8814-6884 ha  
Vasted in NPNCA

A 28550  
10816 10816  
1055-0020 ha  
Government Requirements  
and Compensations  
Creek Inc Ec

PART DOLA PLAN  
COOMALLO (1937-1)  
SCALE 1:50 000