

113

106

114

106/1-7
106/1-8

114/1-1

114/1-2

red line
study area
body is
wrong

should
follow
Coastline



106/1-7
106/1-8

114/1-1

114/1-2

red line study area body is wrong


should follow coast line



Sent to Ag 1/9/06

113

106

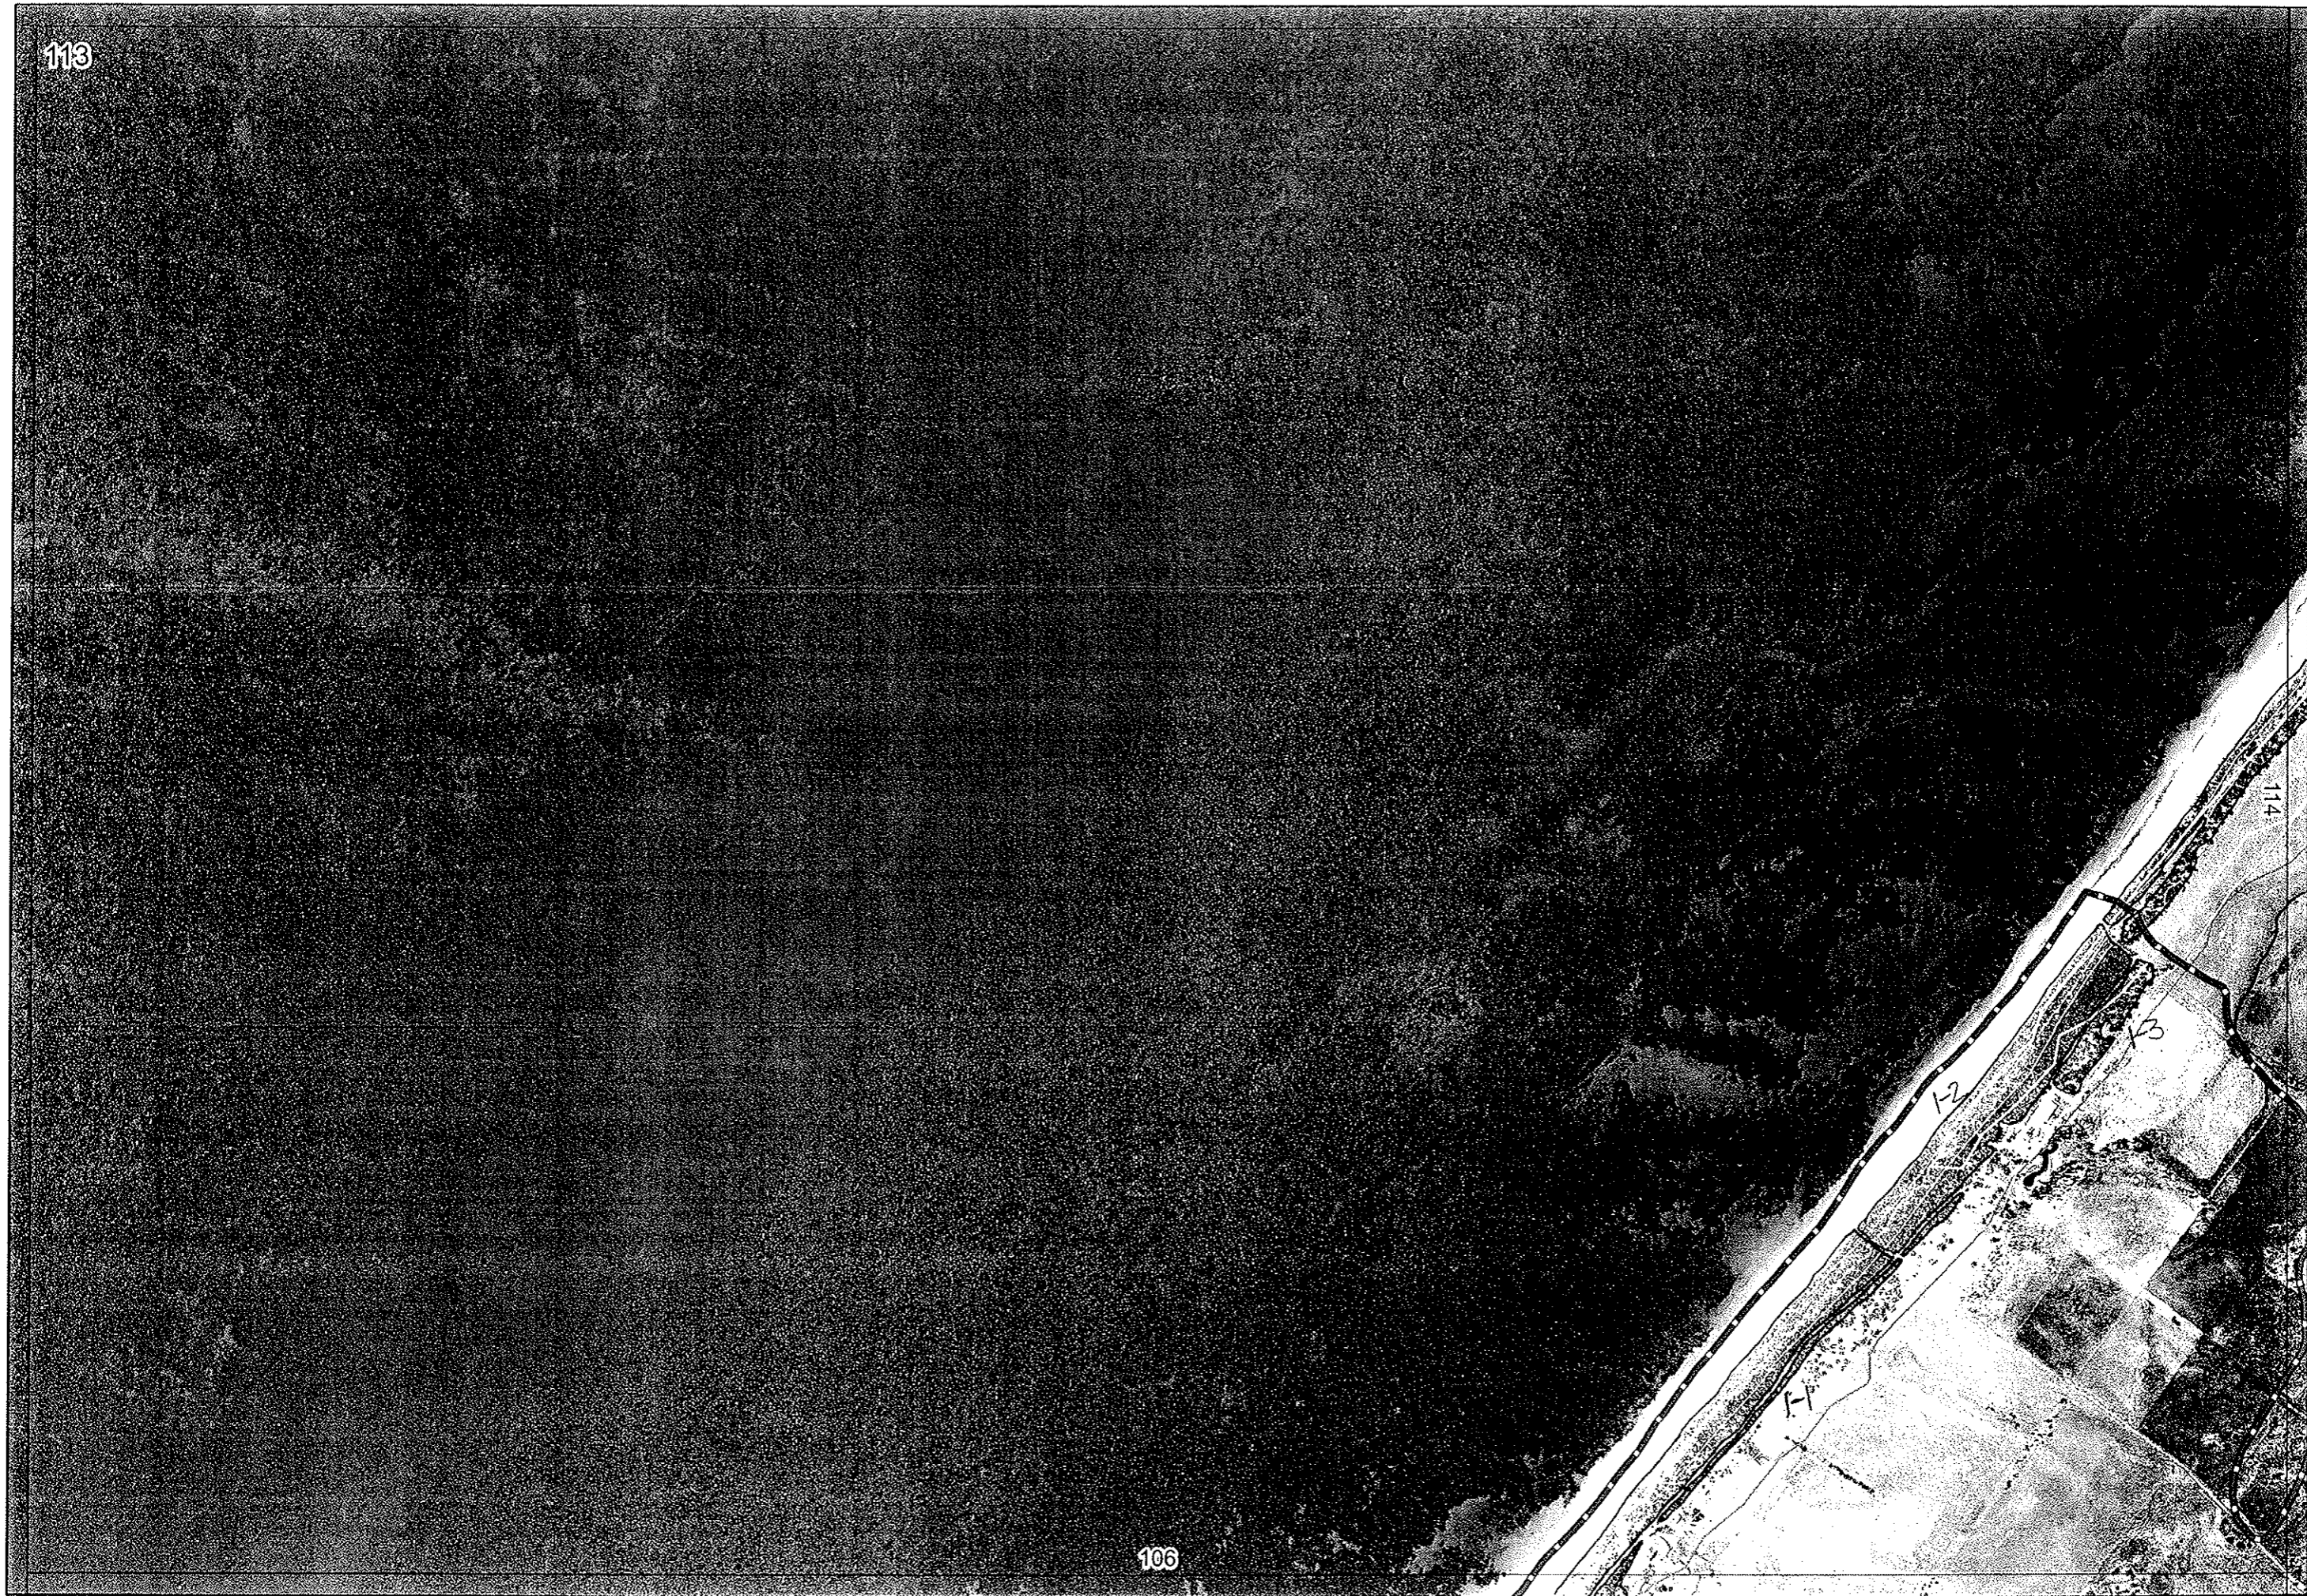

→ 114/1-1

→ 114/1-2

← red line study area body is wrong

← should follow coastline

← 106/1-7
← 106/1-8

Map Sheet Number 113

Pre Field Recorder(s) AW

Field Recorder(s) _____

Swan Bioplan Vegetation Mapping Data

R E M	RE M2	XM AP	LIN TYPE	L I N E A R	M L U	U N I T S	U P L A N D ?	W E T L A N D ?	V I S I T ?	DETAIL/ Area Name	VEG CON	Field date 200_	OBS From	YNOTASS	D E T V I S R E Q D	COMMENTS	VEG STRU C/ DENS	FCT	DOMINANTS			
																			1	2	3	
/ 11	-	road	Y	Q	1	Y	-										W	306	Agofle			
/ 12	-	channel	B	Q	2	Y	-										W	306	Agofle			
																	HS					
13	-	-	-	Q	1	Y	-										W	306	Agofle			

Summary/General Comments _____