


Do not digitise
~~leave out~~

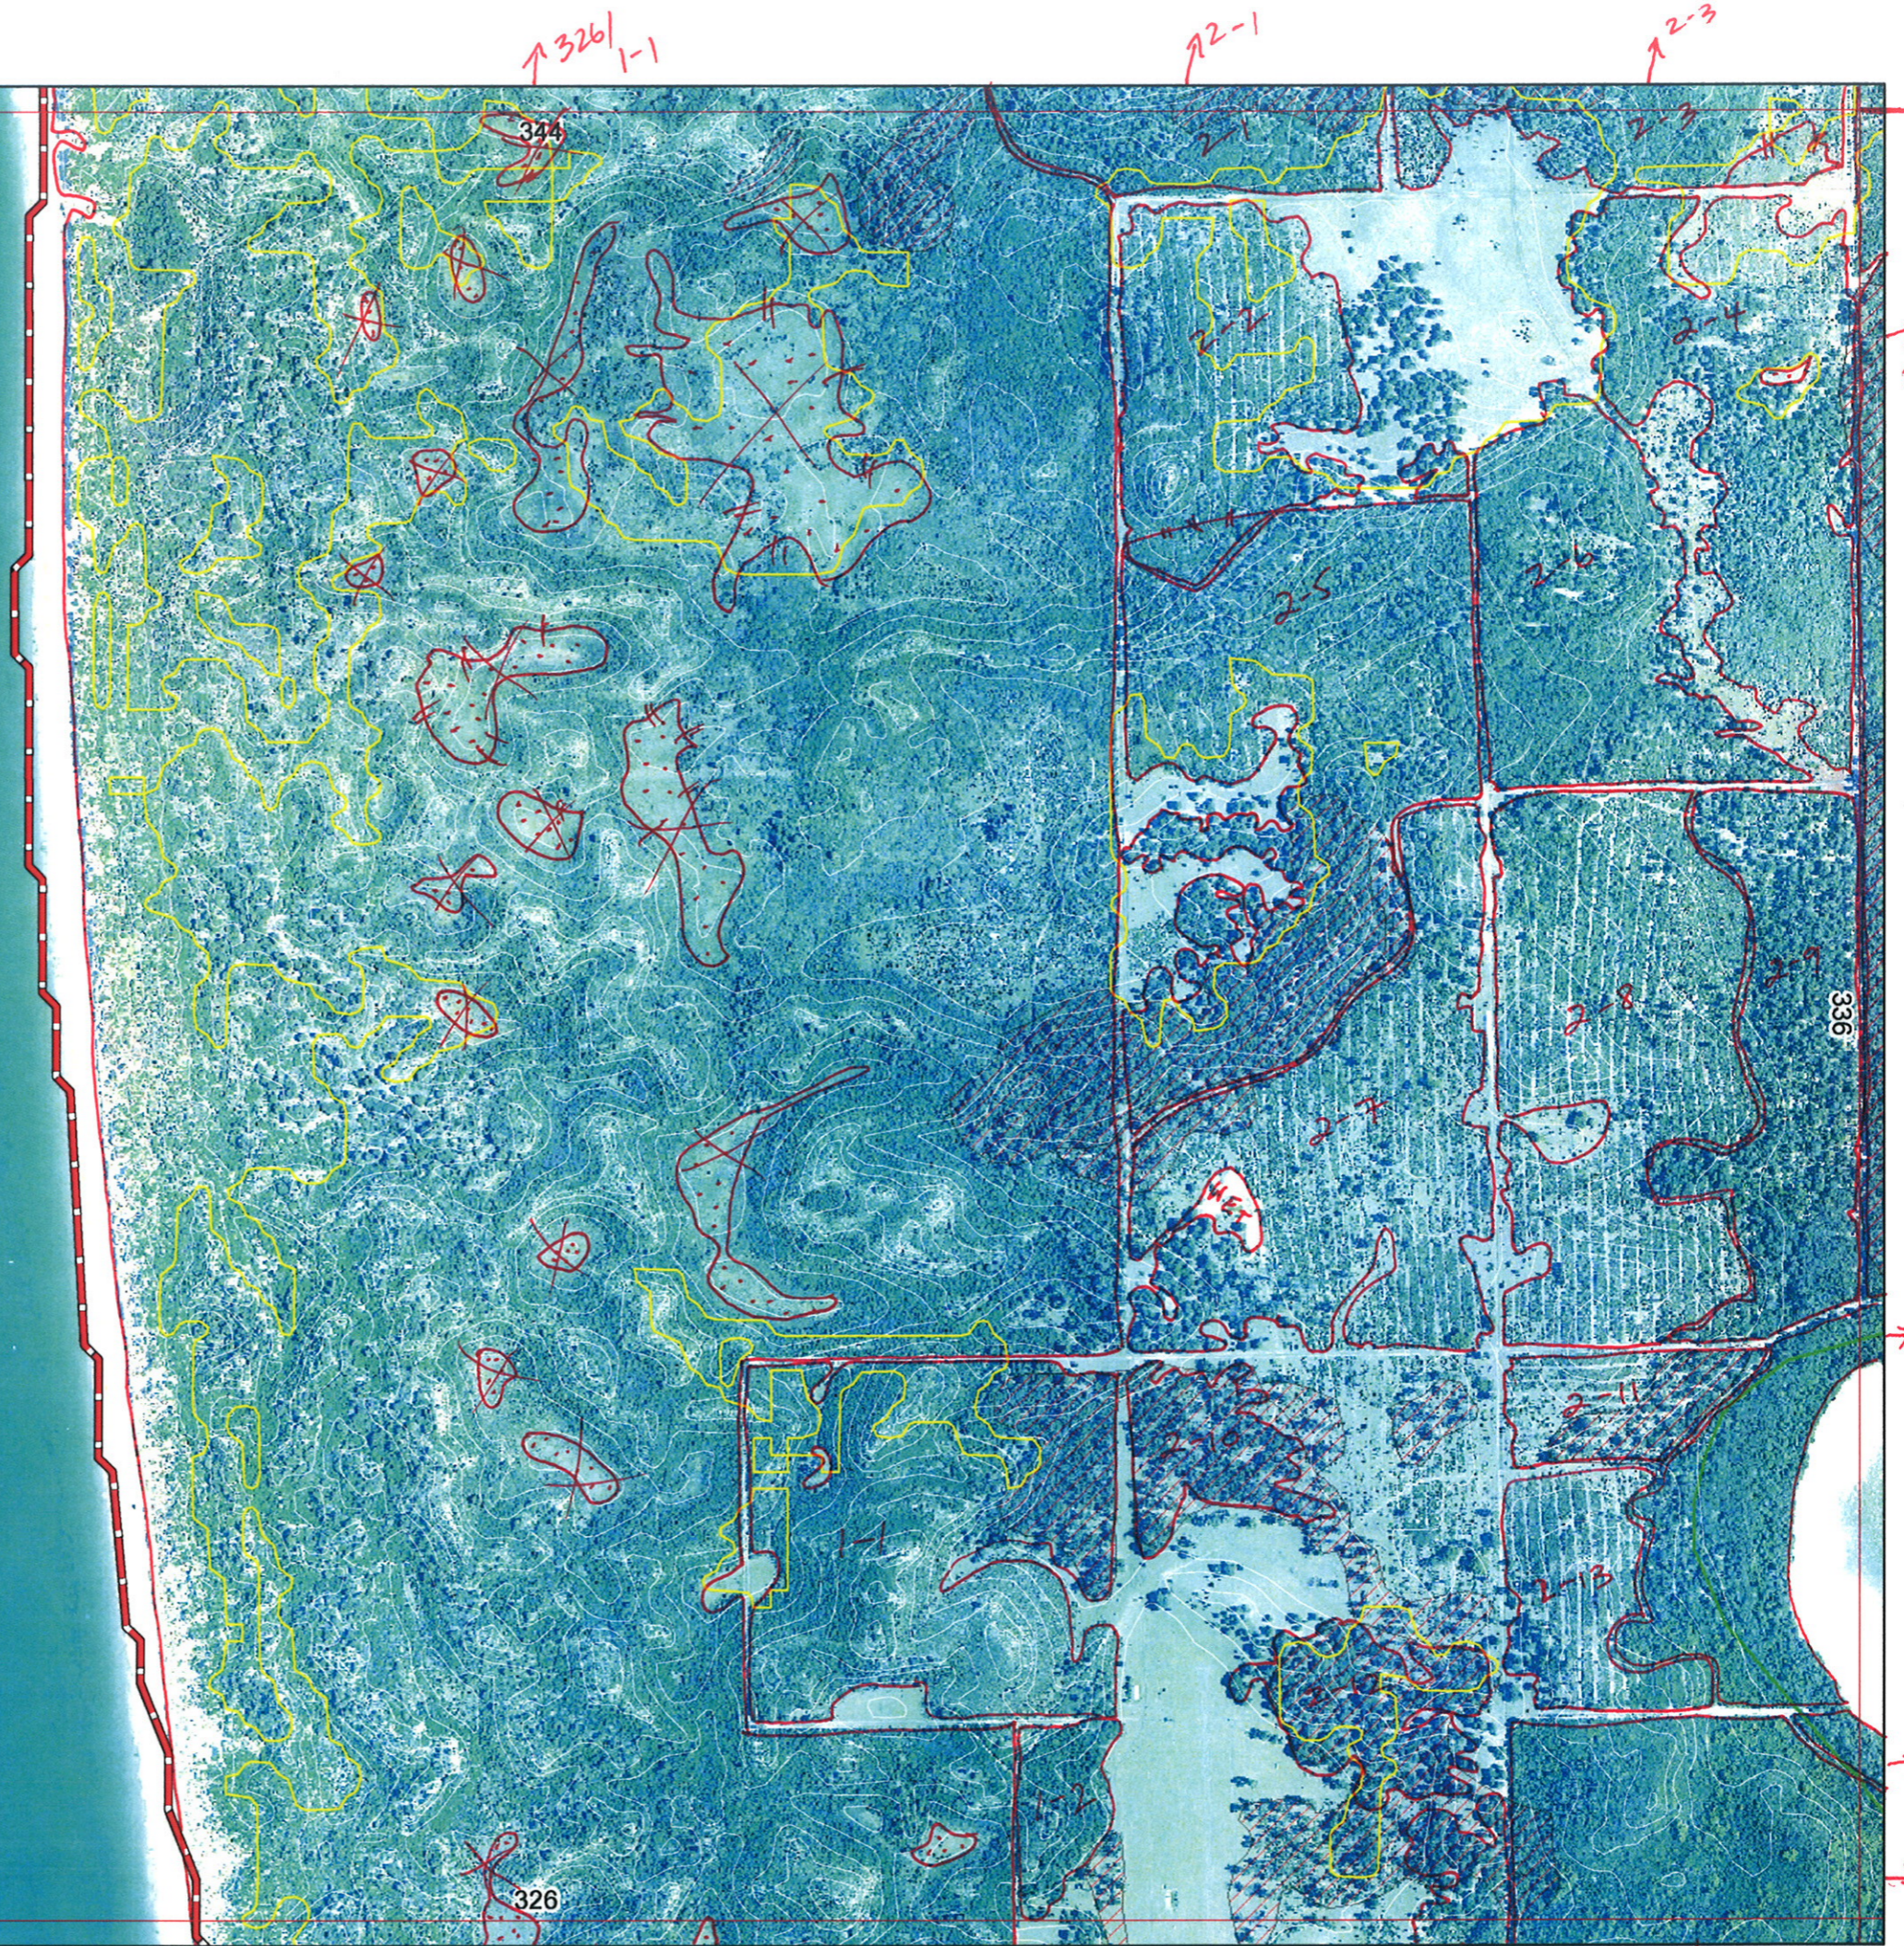

↑ 326/1-1

↑ 2-1

↑ 2-3

344

327/1
2-2

336

336/1
4-1

336/1
4-1

327/1
4-2

326

326/1-1

Q

H

Y

326/1
2-4

327/1
2-7

↑ 326/1-1

↑ 2-1

Sent to Ag 2-7

Do not digitise
~~area~~

335
BJK

→ 327/2-2

→ 336/4-1

→ 336/4-1

→ 327/2-2

↓ 326/1-1

↓ 326/2-4

↓ 327/2-2




No Access

326/1-1

2-1

2-3

335

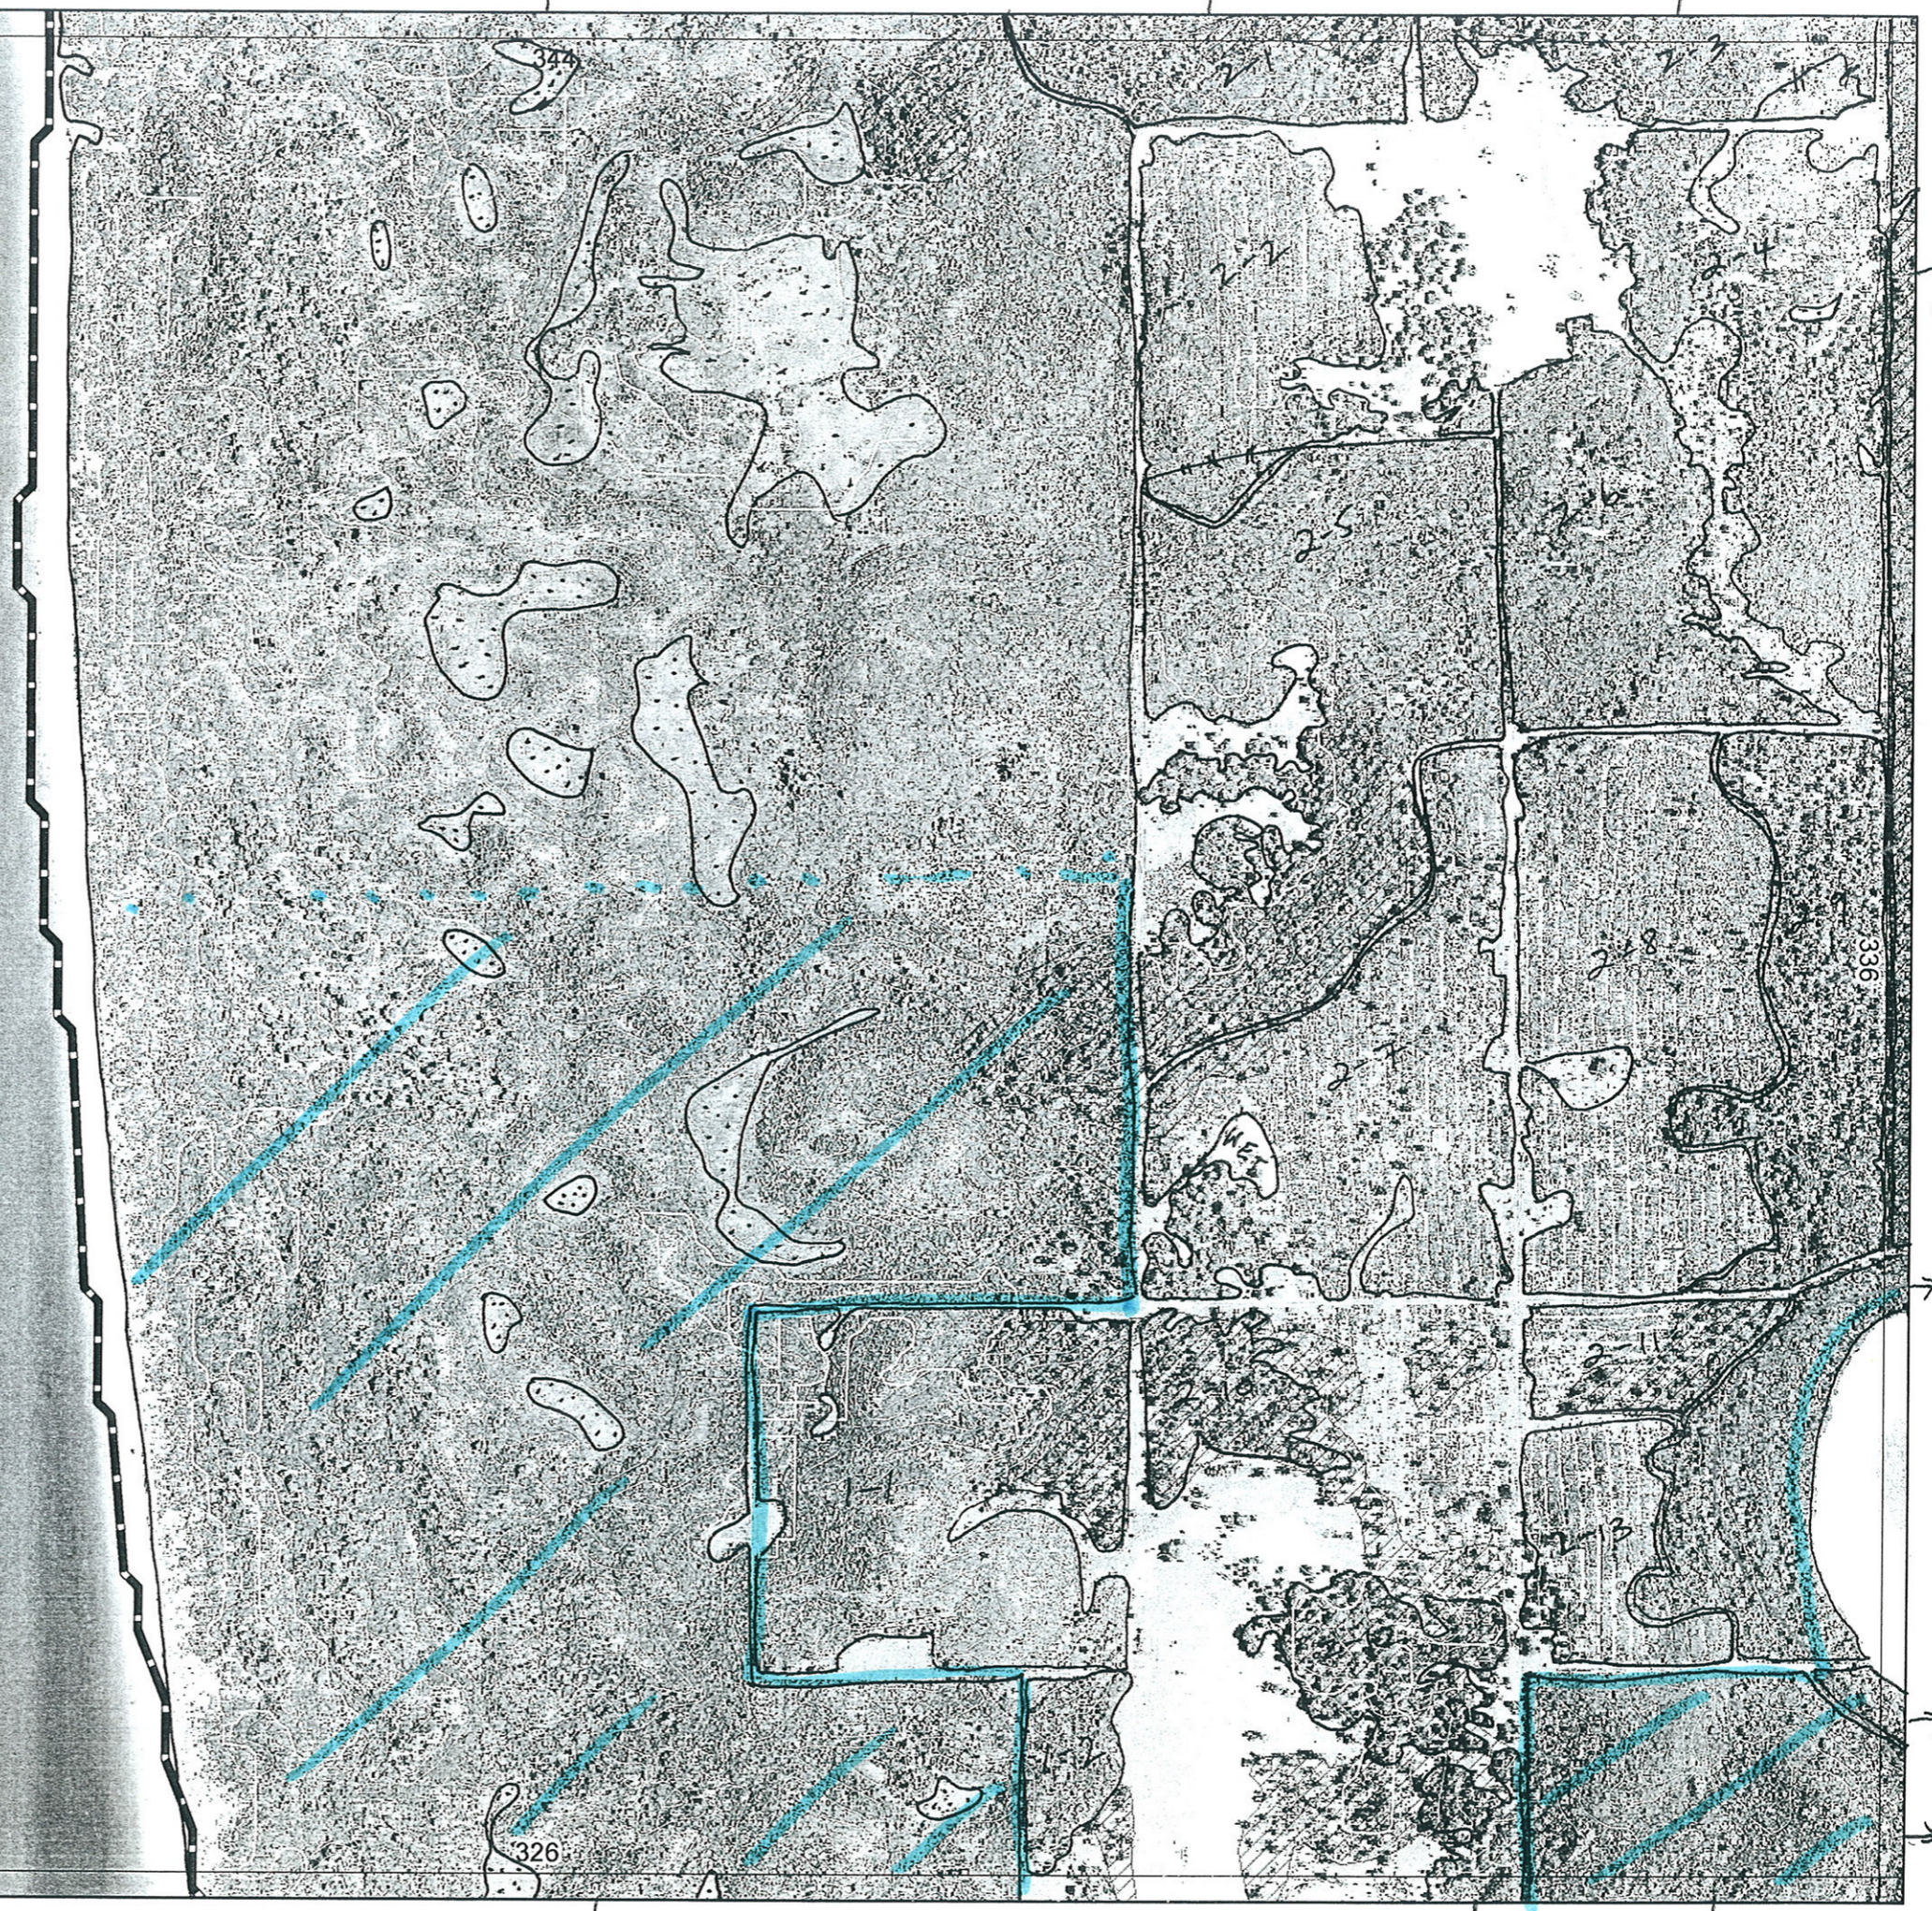

327/2-2

336

336/4-1

336/4-1

327/2-2

326

326/1-1

326/2-4

327/2-2

Map Sheet Number 335

Pre Field Recorder(s) Baib

Field Recorder(s)

Swan Bioplan Vegetation Mapping Data

No Access to any remnants on these sheets.

R E M	RE M2	XM AP	LIN TYPE	L I N E A R	M L U	U N I T S	U P L A N D ?	W E T L A N D ?	V I S I T ?	DETAIL/ Area Name	VEG CON	Field date 200_	OBS From	YNOTASS	D E T V I S R E Q D	COMMENTS	VEG STRUC/ DENS	FCT	DOMINANTS		
																			1	2	3
1	1				M	3	✓				3.7	-	Aerial Int	No Access		Grazed.	W		Eucgom		
																	Sc				
																	HS				
1	2				M	1	✓				3.7	-	Aerial Int.	NO ACCESS		Grazed.	Sc				
2	1	✓			M	3	✓	✓			3		"	"		Grazed.	W		Eucgom		
																	Sc				
																	HS				
2	2				M	3	✓	✓			4.3	-	"	"		Grazed & scrub rolled but looks to be regenerating.	W		Mel sp.		
																	Sc				
																	HS				
2	3	✓			M	4	✓	✓			3.3		"	"		Grazed at edges Expect Eucgom.	W		Eucgom		
2	4				M	3	✓	✓			4.7					Grazed & scrub rolled but restoring.					
2	5				M	4	✓	✓			3.7		"	"		Grazed at edges.	W		Eucgom		
2	6				M	3	✓	✓			3.7		"	"		"					
2	7				M	3	✓	✓			4.7		"	"		Same as 2-2.					
2	8				M	3	✓	✓			4.7		"	"		Same as 2-2					
2	9				M	1	✓	✓			3.7		"	"		Has been rolled & has restored well.	W		Eucgom		
2	10				M	1	✓				5.3		"	"		Grazed.	W		Eucgom.		

Summary/General Comments

